


Section 17 Township 28 Range 4E

Well No. #1 Winters

Company Morris Sitrin

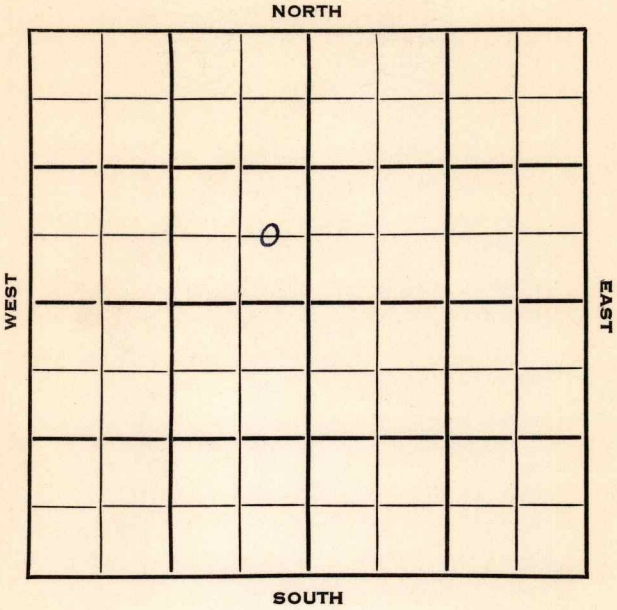

Butler

KANSAS

SEC.	TWP.	R.
17	28	4 E ✓

WELL NO. _____

COMPANY # 1 Winters FARM

CONTRACTOR Morris Sitrin


H & M Drlg.

1950 _____ Ft. from N. Line

_____ Ft. from S. Line

180 _____ Ft. from E. Line

_____ Ft. from W. Line

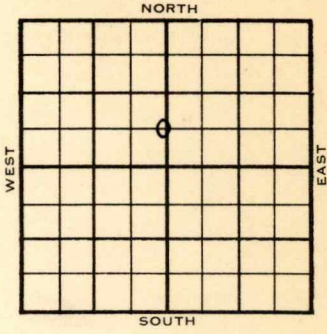

C E L S E N W

	ELEVATION	REPORT
--	-----------	--------

1954

1/20

Spud 1-13-54
 8" @ 65 Arb. 2389'
 TD 2402' 5" @ 2391'

1/27

Spud 1-13-54
 Oil Well
 TD 2402'
 8" @ 65
 Arb. 2389'
 TD 2402'
 5" @ 2391
 CO to 2402
 Comp. 25 bopd

COMPLETED

