

Butler

KANSAS

Sec. 17 Twp. 28 R. 4E

Well No. #1 Winter Farm

C. A. Black Company


Miscellaneous

990' Ft. from N. Line

_____ Ft. from S. Line

_____ Ft. from E. Line

990' Ft. from W. Line

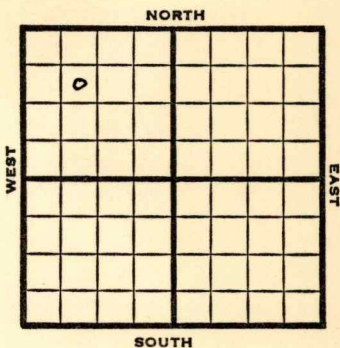

SE NW NW

Elev. 1229' REPORT

1949

8/31

Machine

9/7

Drlg. 805'

9/14

13"@ 932

10"@ 1430'

Drlg 1455'

9/21

Lansing 1735'

8" @ 2118'

Drlg. 2180'

9/27

Miss 2413'

TD 2435'

5"@ 2433'

10/5

TD 2422'

10/12

Arb. 2432'

TD 2445'

10/19

"

10/26

"

11/2

TD 2445'

Arb. 2432'

5 @ 2431'

Pump 10 Oil / 10W Pot

38° Gr.

Comp

COMPLETED

Map No. _____ Sec. 17 Twp. 28 R. 4E

Well No. 1 Winter

C. A. Black Company

SE NW NW Contractor

FIRST REPORT
SECTION PLAT

990 Ft. from N. Line

_____ Ft. from S. Line

_____ Ft. from E. Line

990 Ft. from W. Line

Butler County

Location _____

Rig up _____

Drilling and Remarks:

Machine _____

RECORD

Cased _____ in., _____ ft.

Sand _____

Gas _____

Oil _____

Total Depth _____

PRODUCTION

1st 24 hrs. Nat. _____

1st 24 hrs. after shot _____

Gas _____ Cu. Ft.

Dry Hole _____

Abandoned _____

Date

AUG 31 1949

19

S. J. LEWIS

Scout

Map No. _____ Sec. 17 Twp. 28 R. 4E

Well No. 1 Winter

C. A. Black Company

COMPLETE

Contractor

SE NW NW

E. 1228
SECTION PLAT

990 Ft. from N. Line

_____ Ft. from S. Line

_____ Ft. from E. Line

990 Ft. from W. Line

o			

Butler County

Location _____

Rig up _____

Drilling and Remarks:

Cor 2432
5" @ 2431
Prod. 10 oil 410 W
Prod.
0824

RECORD

Cased _____ in., _____ ft.

Sand _____

Gas _____

Oil _____

Total Depth 2445

PRODUCTION

1st 24 hrs. Nat. _____

1st 24 hrs. after shot _____

Gas _____ Cu. Ft.

Dry Hole _____

Abandoned _____

Date

NOV 2 1949 19

S. J. LEWIS Scout