


Section 29 Township 34 Range 3 E

Well No. # 2 Jones

Company Gross Drlg.

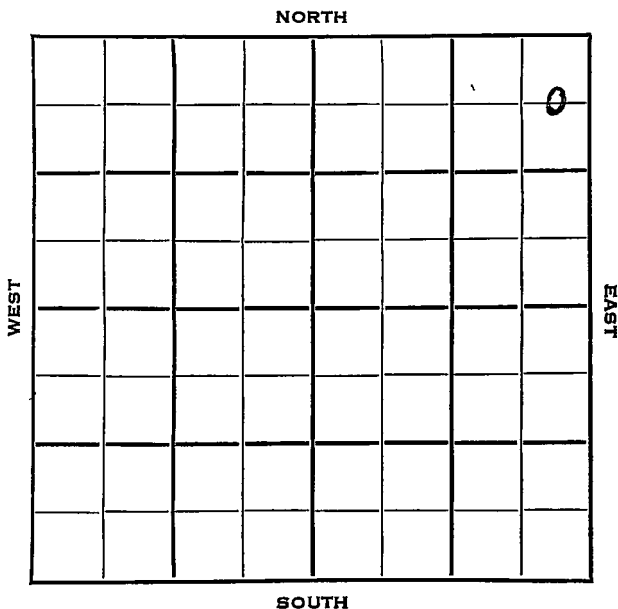

Cowley

KANSAS

Sec. 29 Twp. 34 R. 3 E

Well No. # 2 Jones Farm

Gross Drlg. Company

Gross Drlg. Contractor

Gibson Pool


660 Ft. from N. Line

\_\_\_\_\_ Ft. from S. Line

330 Ft. from E. Line

\_\_\_\_\_ Ft. from W. Line

C E L N E N E

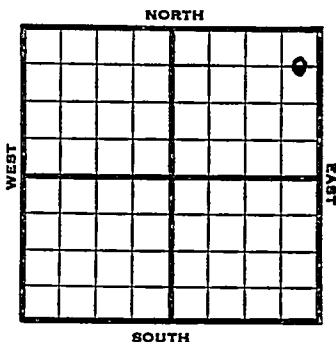

1953

Elev. 1140' REPORT

8/5

Location

10/7

Spud 8-8-53  
 Oil Well  
 TD 3384'  
 8" @ 100'  
 Peacock 1421', Layton 2646', KC 2862  
 Cherokee 3175', Bart 3364,  
 TD 3384'  
 5" @ 3376'  
 CO to 3384'  
 S/ 6 boph 10% wtr. S/ 176 bo 4 hr.  
 Comp. 55 bopd.

**COMPLETED**



