
DX 78-1 O. W. P. B. Ellis KANSAS

Section 21 Township 15 Range 17W

Well No. ~~1 Schmidt~~

Company ~~Sunray Oil~~ THUNDER BIRD Drlg.

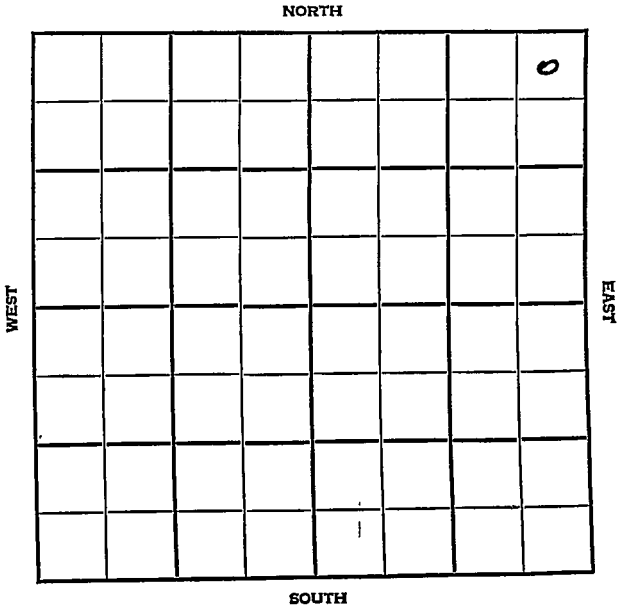

Ellis KANSAS

SEC. O. W. P. B	TWP.	R.
21	15	17W

WELL NO. 1 Schmidt FARM

COMPANY Thunderbird Drlg.
~~Sunray Oil~~

CONTRACTOR Stickle Drlg.


~~Wheatland~~ Degenhardt Pool

330 Ft. from N. Line

Ft. from S. Line

330 Ft. from E. Line

Ft. from W. Line

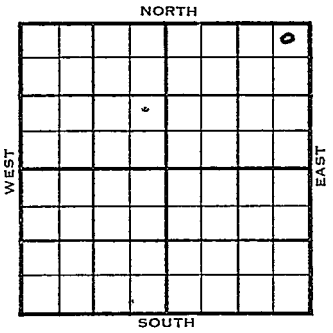

NE NE NE

	ELEVATION 1974' REPORT
1954	
6/8	Loc.
6/23	8" @ 1130' w/800 sks Lans 3262' DST 3281-3308', 1 hr., 60' OCM, 750# Drlg. 3393'
6/30	Spud 6-14-54 D&A TD 3580' 8" @ 1130' Lans 3262' DST 3281-3308', opn 1 hr., rec. 60' ocm, 750# B KC 3506', Marm. 3522', Cong 3539', Arb. 3576' DST 3577-80', opn 1 hr., rec. 120' wtr, 1100# TD 3580' D&A

ABANDONED

OVER

DX-78

1954

O. W. P. B.

9/22 OWPB. Lans 3263' B KC 3504'
Cong 3539', Arb. 3576', 5" @ 3578
w/125. CO 3551' 21/3432-39
Test 1 BO no wtr. 700 A Swab 20
BOPH no wtr. 1200 OB

10/27 Oil Well
TD 3551'
Lans 3263', B KC 3504', Cong 3539',
Arb. 3576'
5" @ 3578'
CO to 3551'
21/3432-39, 1 bo 700A
S/20 boph
P/7 boph
Comp. 105 bopd

COMPLETED

FORM 275 FOR SALE BY KANSAS BLUE PRINT CO.


County Ellis State Kansas

Sec. 21 (Blk. Twp.) 15 (Sur. Rge.) 17W Map No.

Operator Sunray Oil

Well No. 1 Farm Schmidt

Elev. Location NE NE NE

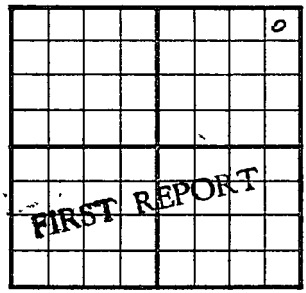

330 Ft. From N Line NE

330 Ft. From E Line Quarter

1st. Report JUN 9 1954

Completion

Remarks Stickle Drlg. - Contr.

Spudding Date

Drlg. Data Degenhardt Pool

Location

J. G. McGEHEE

FORM 275 FOR SALE BY KANSAS BLUE PRINT CO


County Ellis State Kansas

Sec. 21 (Blk. Twp.) 15 (Sur. Rge.) 17W Map No.

Operator Sunray Oil

Well No. 1 Farm Schmidt

Elev. 1974 Location NE NE NE

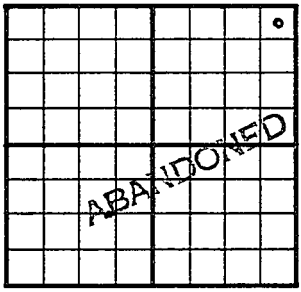

330 Ft. From N Line NE Quarter

330 Ft. From E Line

1st. Report

Completion JUN 30 1954

Remarks Degenhardt Pool
Stickle Drlg. - Contr.

Spudding Date 6-14-54

Drlg. Data D & A TD 3580

8" @ 1130 Lans. 3262 DST 3281-3308

open 1 hr. Rec. 60' ocm 750#

B KC 3506 Marm. 3522 Cong. 3539

Arb. 3576 DST 3577-80 open 1 hr.

Rec. 120' wtr. 1100# TD 3580

D & A

J. G. McGEHEE

FORM 275 FOR SALE BY KANSAS BLUE PRINT CO

O. W. P. B.


County Ellis State Kansas

Sec. 21 (Blk. Twp.) 15 (Sur. Rge.) 17W Map No.

Operator Thunderbird Drlg. (was Sunray)

Well No. 1 Farm Schmidt

Elev. Location NE NE NE

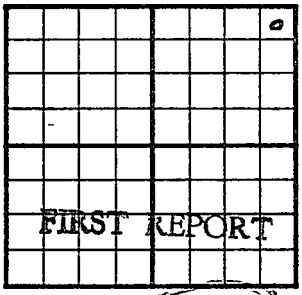

330 Ft. From N Line NE

330 Ft. From E Line Quarter

1st. Report SEP 22 1954

Completion

Remarks O. W. P. B.

Spudding Date

Drlg. Data O.W.P.B. Wheatland

Lans 3263, BKC 3504, Cong 3539, Arb 3576

5" @ 3578 w/125, C/O 3551, 21/3432-39, Test 1

BO no wtr, 700A, Swb 20 BOPH no wtr, 1200 OB

FABEN GILSTRAP

FORM 275 FOR SALE BY KANSAS BLUE PRINT CO.

O.W.P.B.


County Ellis State Kansas

Sec. 21 (Blk. Twp.) 15 (Sur. Rge.) 17W Map No.

Operator Thunderbird Drlg. (was Sunray)

Well No. 1 Farm Schmidt

Elev. Location NE NE NE

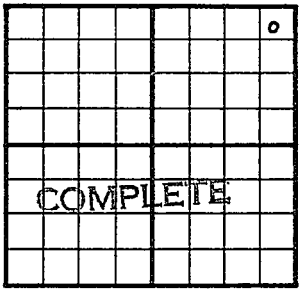

330 Ft. From N Line NE Quarter

330 Ft. From E Line

1st. Report

Completion OCT 27 1954

Remarks (OWPB)

O.W.P.B.

Spudding Date

Drlg. Data Oil well TD 3551

Lans. 3263 B KC 3504 Cong. 3539

Arb. 3576 5" @ 3578 CO to 3551 21/

3432-39 1 bo 700 A S/ 20 boph

P/ 7 boph Comp. 105 bopd

FABEN GILSTRAP