


Section 29 Township 34 Range 3E

Well No. #3 Jones

Company Gross Drlg.

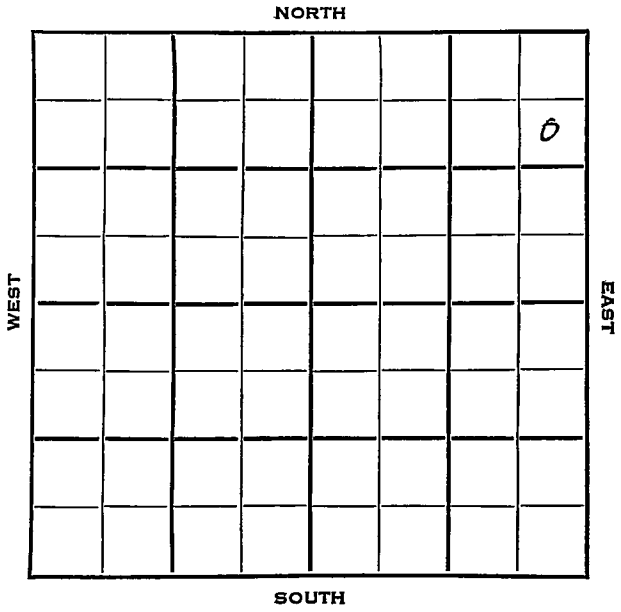

Cowley

KANSAS

|            |            |            |
|------------|------------|------------|
| SEC.<br>29 | TWP.<br>34 | R.<br>3E ✓ |
|------------|------------|------------|


WELL NO. #3 Jones FARM

COMPANY Gross Drlg.

CONTRACTOR Gross Drlg.

Gibson Drlg.

990 Ft. from N. Line  
 Ft. from S. Line  
 330 Ft. from E. Line  
 Ft. from W. Line

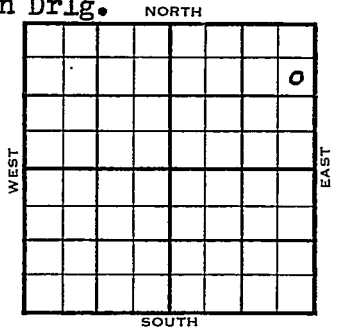

SE NE NE

|      |                    |        |
|------|--------------------|--------|
| 1954 | ELEVATION<br>1136' | REPORT |
|------|--------------------|--------|

2/3 Cellar & Pits.

5/5 Spud 2-17-54 Oil well TD 3386  
 8" @ 98 Layton 2659 KC 2857  
 TD 3386 5" @ 3367 CO to 3386  
 Bart. 3360 sd-frac. S/8 BOPH  
 Comp. 56 BOPD 18% wtr.

**COMPLETED**

County **Cowley** State **Kansas**

Sec. **29** (Blk. Twp.) **34** (Sur. Rge.) **3E** Map No.

Operator **Gross Drlg.**

Well No. **3** Farm **Jones**

Elev. Location **SE NE NE**

|  |  |  |  |  |  |  |   |
|--|--|--|--|--|--|--|---|
|  |  |  |  |  |  |  |   |
|  |  |  |  |  |  |  |   |
|  |  |  |  |  |  |  | o |
|  |  |  |  |  |  |  |   |
|  |  |  |  |  |  |  |   |
990 Ft. From **N** Line **NE**

330 Ft. From **E** Line Quarter

Ist. Report **FEB 3 1954**

Completion:

Remarks

**Gross Drlg. - Contr.**

Spudding Date

Drlg. Data **Gibson Pool**

**Cellar & pits**

