


Map No. _____ Sec. 18 Twp. 28 R. 4
 Well No. 2 Salter Farm _____
Silver Leaf Company _____

NORTH

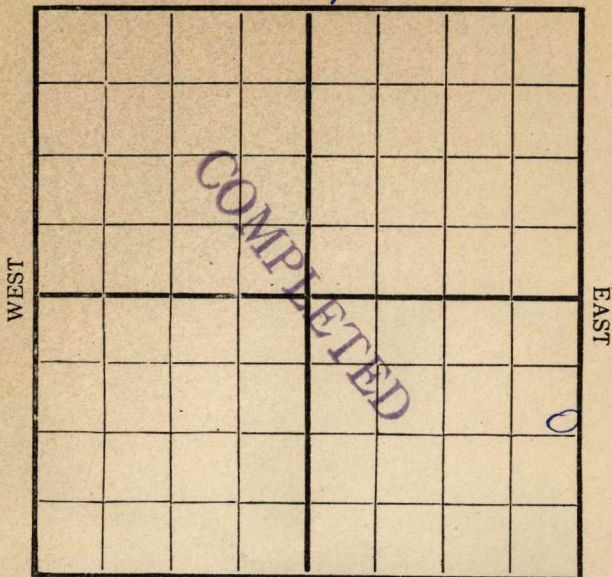

SOUTH

Location _____

Drilling Remarks:

6/23-150

Rig Up _____

Drilling Remarks:

RECORD

Cased _____ in _____ Ft.
 Sand _____
 Gas _____
 Oil _____
 Total Depth _____

PRODUCTION

1st 24 hrs. Nat. _____
 1st 24 hrs. after shot _____
 Gas _____ Cu. Ft.
 Dry Hole _____
 Abandoned _____

Map No. _____ Sec. 18 Twp. 28 R. 4
 Well No. Seller Farm _____
Silver Leaf Company _____

NORTH

WEST

EAST

SOUTH

Location _____
 Rig Up _____
 Drilling and remarks _____

150'

RECORD

Cased _____ in. _____ Ft.
 Sand _____
 Gas _____
 Oil _____
 Total Depth _____

PRODUCTION

1st 24 hrs. Nat. _____
 1st 24 hrs. after shot _____
 Gas _____ Cu. Ft.
 Dry Hole _____
 Abandoned _____

Date

6/23, 1916 L. C. ... Scout

Map No. _____ Sec. 18 Twp. 28 R 4Well No. 12 Salter Farm _____
Silver Leaf Company _____

NORTH

WEST

EAST

SOUTH

Location _____

Rig Up _____

Drilling and remarks
1100'

RECORD

Cased _____ in. _____ Ft.

Sand _____

Gas _____

Oil _____

Total Depth _____

PRODUCTION

1st 24 hrs. Nat. _____

1st 24 hrs. after shot _____

Gas _____ Cu. Ft.

Dry Hole _____

Abandoned _____

Date


7/17, 1916 Scout

Map No. _____ Sec. 18 Twp. 28 R 4
 Well No. 2 Solter Farm _____
Silver Leaf Company _____

NORTH

WEST

EAST

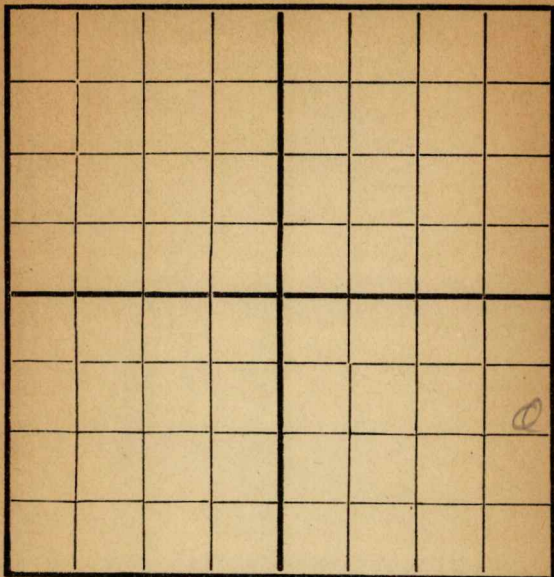

SOUTH

Location _____
 Rig Up _____
 Drilling and remarks _____

1500'

RECORD

Cased _____ in. _____ Ft.
 Sand _____
 Gas _____
 Oil _____
 Total Depth _____

PRODUCTION

1st 24 hrs. Nat. _____
 1st 24 hrs. after shot _____
 Gas _____ Cu. Ft.
 Dry Hole _____
 Abandoned _____

Date

7/31, 1916 L. C. Camp Scout

Map No. _____ Sec. 18 Twp. 28 R. 4Well No. 2 Farm _____

_____ Company _____

NORTH

WEST

EAST

SOUTH

Location _____

Rig Up _____

Drilling and remarks

Shot down

RECORD

Cased _____ in. _____ Ft.

Sand _____

Gas _____

Oil _____

Total Depth _____

PRODUCTION

1st 24 hrs. Nat. _____

1st 24 hrs. after shot _____

Gas _____ Cu. Ft.

Dry Hole _____

Abandoned _____

Date


8/8, 1916 Scout

Map No. _____ Sec. 18 Twp. 28 R. 4
 Well No. 2 Salter Farm _____
Silver Leaf Company _____

NORTH

WEST

EAST

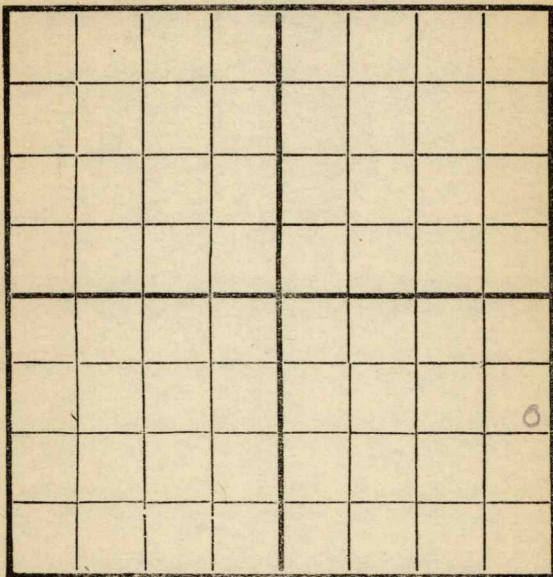

SOUTH

Location _____

Rig Up _____

Drilling and remarks

1700Shut DownWaiting forCompany

RECORD

Cased _____ in. _____ Ft.

Sand _____

Gas _____

Oil _____

Total Depth _____

PRODUCTION

1st 24 hrs. Nat. _____

First 24 hrs. after shot _____

Gas _____ Cu. Ft.

Dry Hole _____

Abandoned _____

Date

8/151916W. C. B. J.

Scout

Map No. _____ Sec. 18 Twp. 28 R. 4Well No. 2 Salter Farm _____Silver Leaf Company _____

NORTH

WEST

EAST

SOUTH

Location _____

Rig Up _____

Drilling and remarks

2050

RECORD

Cased _____ in. _____ Ft.

Sand _____

Gas _____

Oil _____

Total Depth _____

PRODUCTION

1st 24 hrs. Nat. _____

First 24 h.s. after shot _____

Gas _____ Cu. Ft.

Dry Hole _____

Abandoned _____

Date

8/25 1916Scout

Map No. _____ Sec. 18 Twp. 28 R. 4
 Well No. 2 Sutter Farm _____
Silver Leaf Company _____

NORTH

WEST

EAST

SOUTH

Location _____

Rig Up _____

Drilling and remarks

2275'Cased 6 5/8'

RECORD

Cased _____ in. _____ Ft.

Sand _____

Gas _____

Oil _____

Total Depth _____

PRODUCTION

1st 24 hrs. Nat. _____

1st 24 hrs. after shot _____

Gas _____ Cu. Ft.

Dry Hole _____

Abandoned _____

Date


AUG 301916S. C. Carduff

Scout

Map No. _____ Sec. 18 Twp. 28 R. 4
 Well No. 2 Saltwater Farm _____
Silver Leaf Company _____

NORTH

WEST

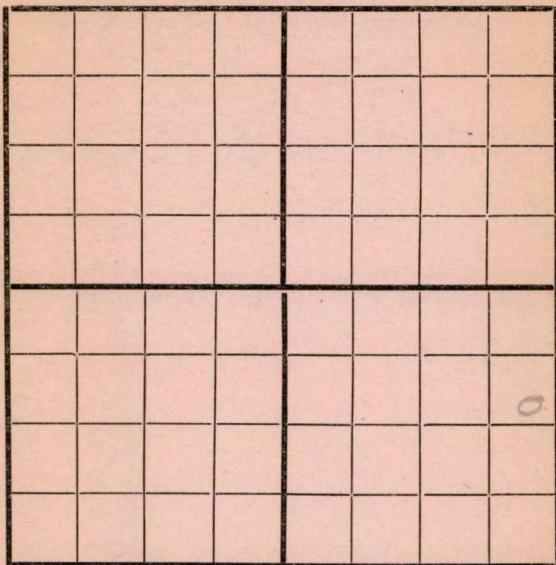

EAST

SOUTH

Location _____

Rig Up _____

Drilling and remarks

2370

RECORD

Cased _____ in. _____ Ft.

Sand _____

Gas _____

Oil _____

Total Depth _____

PRODUCTION

1st 24 hrs. Nat. _____

1st 24 hrs. after shot _____

Gas _____ Cu. Ft.

Dry Hole _____

Abandoned _____

Date

9/4, 1916 Scout

MAP No. K11 **KANSAS** SEC. 18 TWP. 28S R. 4E

WELL No. 1 Salter

Silver Leaf Oil COMPANY

CONTRACTOR

ABANDONED

SECTION PLAT

_____ FT. FROM N. LINE

_____ FT. FROM S. LINE

_____ FT. FROM E. LINE

_____ FT. FROM W. LINE

LOCATION _____

RIG UP _____

DRILLING AND REMARKS:

RECORD

CASED _____ IN. _____ FT.

SAND _____

GAS _____

OIL _____

TOTAL DEPTH 2480

PRODUCTION

1ST 24 HRS. NAT. _____

1ST 24 HRS. AFTER SHOT _____

GAS _____ CU. FT.

DRY HOLE ✓

ABANDONED ✓

DATE


9/13 1926 SCOUT

Map No. _____ Sec. 18 Twp. 28 R 4
 Well No. 2380 Farm _____
Silver Leaf Company _____

NORTH

WEST

EAST

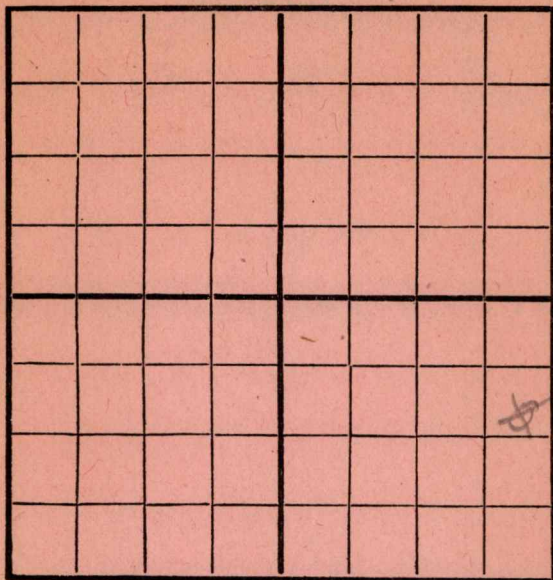

SOUTH

Location _____

Rig Up _____

Drilling and remarks

*Water from
 2380 to 2390
 will probably
 plug*

RECORD

Cased _____ in. _____ Ft.

Sand 2370-2380

Gas _____

Oil _____

Total Depth _____

PRODUCTION

1st 24 hrs. Nat. _____

1st 24 hrs. after shot _____

Gas _____ Cu. Ft.

Dry Hole _____

Abandoned _____

Date

9/12, 1916 6 Lecky Scout