


Ellis

KANSAS

SECTION 22 TOWNSHIP 15S RANGE 17W

WELL NO. #1 Roth "B"

COMPANY Alpine O&R

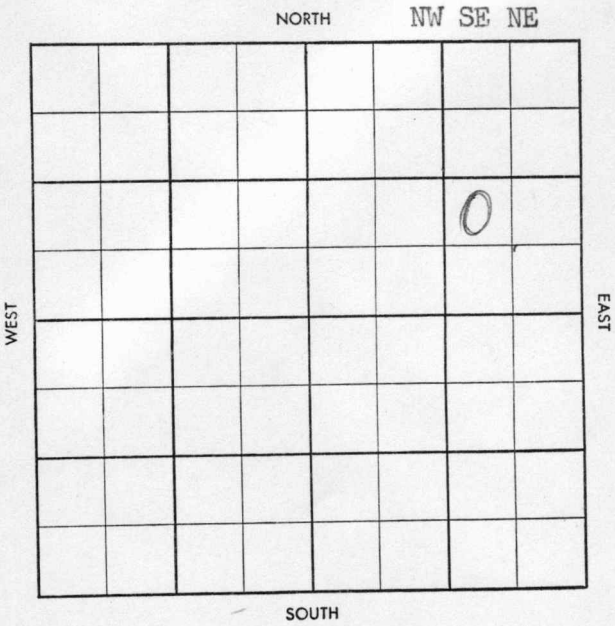


✓
14

County Ellis Elev. 1983RB
 Sec. 22 Twp. 15 Rge. 17W
 Company Alpine O. & R.
 Farm Name Roth "B" No. 1

TOPS	DEPTH	LOG	DATUM
Anh.			
Tp.			
H.	3233		
Tr.			
Dg.			
B.L.			
L.	3281		
K.C.			
B.K.C.			
Ce.			
C.			
M.			
M.			
K.			
Mz.			
Mq.			
V.			
S.			
S.			
A.			
R.			
Pf.			
G.			
T.D.			

Loc. in Sec. NW SE NE
 Geol. _____
 Contr. _____
Quaker Drlg.
 Pool _____
Degenhart SE

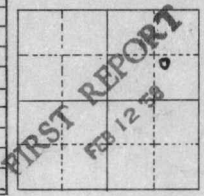


Date Comm. 2/4/58
8" @ 1119 w/550, DST 3294-3335 op 1 hr. rec
6' mud, BHP 850/20, Drlg. 3340.

Co.
 Sec.
 No.
 Sec.
 T.
 R.

County Ellis Elev. 1983RB 1981 DF
 Sec. 22 Twp. 15 Rge. 17W
 Company Alpine O. & R.
 Farm Name Both "B" No. 1

TOPS	DEPTH	LOG	DATUM
Anh.			
Tp.			
H.	3233		
Tr.			
Dg.			
B.L.			
L.	3281		
K.C.			
B.K.C.	3512		
Ce.			
C.	3546		
M.			
M.			
K.			
Mz.			
Mq.			
V.			
S.			
S.			
A.	3583		
R.			
Pf.			
G.			
T.D.	3612		

Loc. in Sec. NW SE NE
~~NEWS~~
 Geol. _____
 Contr. _____
Quaker Drlg.
 Pool _____
Degenhart SE

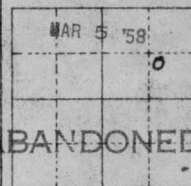

Date Comm. 2/4/58
8" @ 1119 w/550, DST 3294-3335 op 1 hr. rec
6' mud, BHP 850/20, Drlg. 3340. FEB 19 58
DST 3342-90 60" 60' M
BHP 060/20 DST 3463-3510
60" 15M BHP 40/20 DST 3586
-94 60" 23' M BHP 1033/20
no log FEB 26 58 MAR 5 58

D&A

Co.

Loc.

No.

Sec.

T.

R.