


Section 29 Township 34 Range 3E

Well No. 1 Jones

Company Gross Drilling

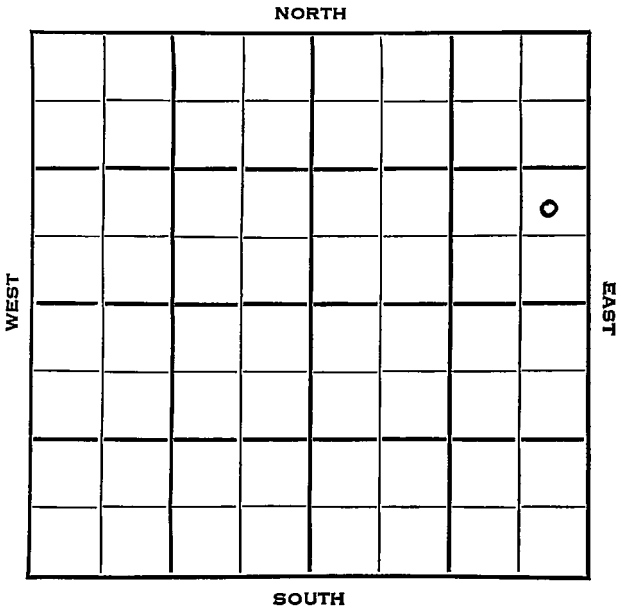

Cowley

KANSAS

SEC.	TWP.	R.
29	34	3 E

WELL NO.

4 Jones

FARM

COMPANY

Gross Drlg.

CONTRACTOR

Gross Drlg.

Gibson Pool


Ft. from N. Line

990 Ft. from S. Line

330 Ft. from E. Line

Ft. from W. Line

NE SE NE

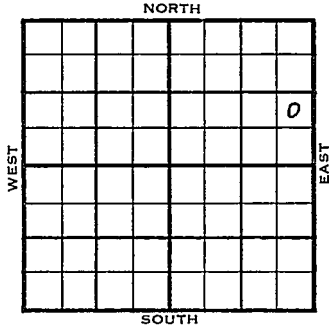

	ELEVATION	REPORT
1954	1129'	

3/10 Spud 3-4-54
8" @ 83
Drlg. 2640'

5/19 Spud 3-4-54
Oil Well
TD 3391'
8" @ 83'
Bart 3358',
TD 3391'
5" @ 3373'
CO to 3388' sd-oil-frac. S/ 4 boph
P/ 30 bo 6 hr.
Comp 49 bopd 46% Wtr.

COMPLETED

