

Kansas


Russell


FORM 51 5M 4-41 PETROL

Section 27 Township 15 Range 14-W

Well No. #1 Michaelis

Company Anderson & Pritchard et al
(Trapp)

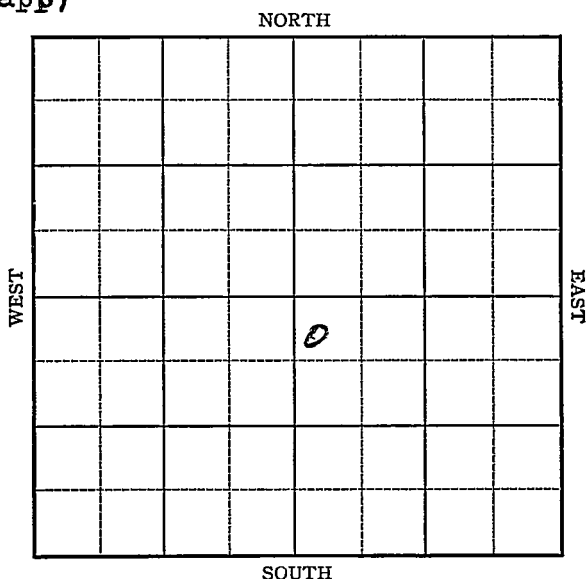

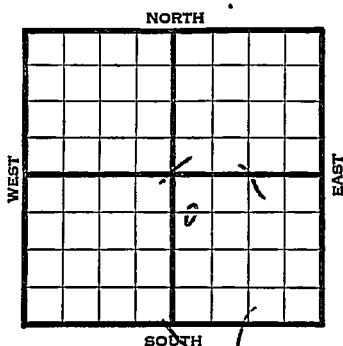
[illegible]

Map No. 73 Sec. 27 Twp. 15 R. 14WWell No. 1 MichaelisAnderson & Pritchard etal
CompanyFIRST REPORT

Contractor

C W L NW SE

SECTION PLAT

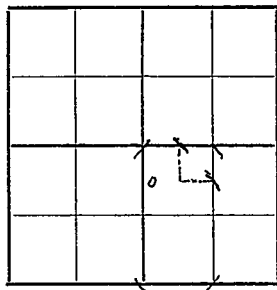660 Ft. from N. Line Ft. from S. Line Ft. from E. Line330 Ft. from W. Line

TRAPP POOL

Location Rig up

Drilling and Remarks:

Drlg. 477

8" - 448 WOC

RECORD

Cased in., ft.Sand Gas Oil Total Depth

PRODUCTION

1st 24 hrs. Nat. 1st 24 hrs. after shot Gas Cu. Ft.Dry Hole Abandoned

Date

JUL 23 1941

19

S. J. LEWIS

Scout

Don: Lewis has the lease, lines on this ticket
cutting thru Cities Service #1 comp. well located
in center N. L. N/2 SE/4. Please check.

Pittman

Misc. Small Maps	
Cards	
Tracing	
France Map	
Scarborough Map	
Moody Map	
Geological Dept.	
Moody Flat Book	

Map No. _____ Sec. 27 Twp. 15 R. 14W

Well No. 1 Michaelis

Anderson & Pritchard etal Company

CORRECTION Contractor

C W L NW SE

660 Ft. from N. Line


_____ Ft. from S. Line

_____ Ft. from E. Line

330 Ft. from W. Line

TRAPP POOL

SECTION PLAT

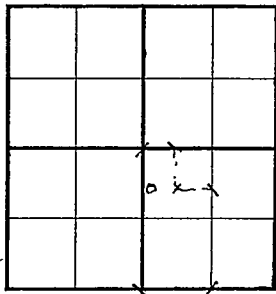

Location _____

Rig up _____

Drilling and Remarks:

Corrected
Drill Site

RECORD

Cased _____ in., _____ ft.

Sand _____

Gas _____

Oil _____

Total Depth _____

PRODUCTION

1st 24 hrs. Nat. _____

1st 24 hrs. after shot _____

Gas _____ Cu. Ft.

Dry Hole _____

Abandoned _____

Date

AUG 9 1941 19

S. J. LEWIS Scout

Map No. _____ Sec. 27 Twp. 15 R. 14W

Well No. 1 Michaelis

Anderson & Pritchard et al
Company

Contractor

ABANDONED

SECTION PLAT

C W L NW SE

		0	

660 Ft. from N. Line

_____ Ft. from S. Line

_____ Ft. from E. Line

330 Ft. from W. Line

TRAPP POOL

Location _____

Rig up _____

Drilling and Remarks:

CR 83365

Water.

RECORD

Cased _____ in., _____ ft.

Sand _____

Gas _____

Oil _____

Total Depth 3395

PRODUCTION

1st 24 hrs. Nat. _____

1st 24 hrs. after shot _____

Gas _____ Cu. Ft.

Dry Hole _____

Abandoned _____

Date

AUG 6 1941 19 S. J. LEWIS Scout