


DX 78-1 Rush

KANSAS

Section 26 Township 18 Range 16W

Well No. #1 Strong

Company L. C. Knight

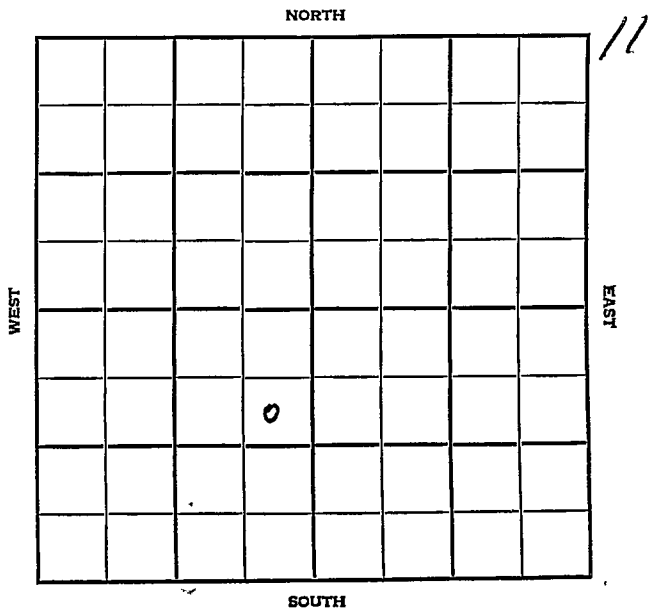

Rush

KANSAS

SEC.	TWP.	R.
26	18	16W

WELL NO.

#1 Strong

FARM

COMPANY

L.C. Knight

CONTRACTOR

Co. Tools.

Otis-Albert Pool

NORTH

990


Ft. from N. Line

Ft. from S. Line

330

Ft. from E. Line

Ft. from W. Line

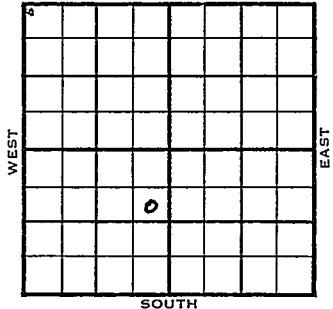

SE NE SW

1954

ELEVATION

1943'

REPORT

11/3  
12/8

RUR

Spud 11-3-54

D &amp; A

TD 3566 $\frac{1}{2}$ '

Anhy 989'

8-5/8" @ 994'

Heeb 3202', Br. Lime 3254' Lans 3266

B KC 3499' Cong 3524' Reagan 3559'

TD 3566'

5" @ 3565'

DD 3566 $\frac{1}{2}$ 'frac. S/  $\frac{1}{2}$  bo 20 bwph

D &amp; A

ABANDONED

County **Rush** State **Kansas**

Sec. **26** (Blk. Twp.) **18** (Sur. Rge.) **16W** Map No.

Operator **L. C. Knight**

Well No. **1** Farm **Strong**

Elev. Location **SE NE SW**


**FIRST REPORT**

**990** Ft. From **N** Line **SW**

**330** Ft. From **E** Line **Quarter**

Ist. Report **NOV 3 1954**

Completion

Remarks

**Co. tools**

Spudding Date

Drig. Data **Otis-Albert Pool**

**RUR**

County Rush State Kansas

Sec. 26 (Blk. 18) (Sur. Rge.) 16W Map No.

Operator L. C. Knight

Well No. 1 Farm Strong

Elev. 1943 Location SE NE SW

ABANDONED									

990 Ft. From N Line SW

330 Ft. From E Line Quarter

1st. Report

Completion DEC 8 1954

Remarks Otis-Albert Pool

Co. tools

Spudding Date 11-3-54

Drilg. Data D & A TD 3566 $\frac{1}{2}$

Anhy 989 8 5/8" @ 994 Heeb. 3202

Br. lime 3254 Lans. 3266 B KC 3499

Cong. 3524 Reagan 3559 TD 3566

5" @ 3565 DD 3566 $\frac{1}{2}$  frac

S/  $\frac{1}{2}$  bo 20 bwph

D & A