

9 PETROL KANSAS

Well No. #1 Leiker

Company Alpine Oil Royalty Co.

ISAM

EAST

SOUTH

KANSAS Ellis

Sec. 18 Twp. 15 R. 17-W

Well No. #1 Leiker Farm

Alpine Oil & Royalty Company

Cont-- Alpine

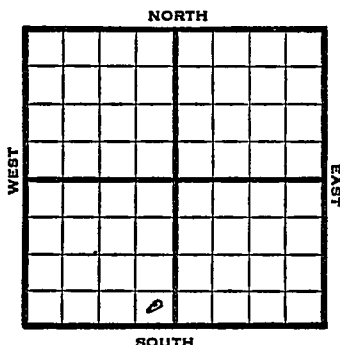
Ft. from N. Line

330 Ft. from S. Line

Ft. from E. Line

330 Ft. from W. Line

SE SW



1949	Elev. 1998'	REPORT
10/12	RUR	
10/19	8"@ 1156'	
	Drlg 2440'	
10/26	Lansing 3297'	
	Arbuckle 3569'	
	TD 3578'	
	5" @ 3571'	
11/1	TD 3585'	
	Acid 500	
	Swb 5 bbls oil PH, 8 hrs.	
11/9	"	
11/16	"	
11/23	"	
11/29	"	
12/7	"	
12/14	"	
12/21	"	
12/28	"	
1950		
1/11	TD 3585'	
	8"@ 1156'	
	5"@ 3571'	
	PP 152 BOPD 5% wtr.	
	Gr 32.1	
	Anhy 1150'	
	Topk 2994'	
	Heb 3248'	
	Lans 3297'	
	Arb. 3569'	
	Comp	

COMPLETED

Kansas

Map No. _____ Sec. 18 Twp. 15 R. 17WWell No. 1 Leiker

_____ Alpine Oil & Royalty _____ Company

_____ Alpine _____ Contractor

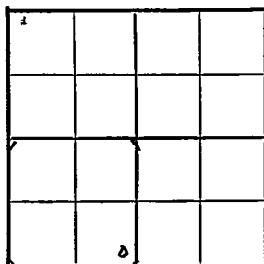
SE SW

FIRST REPORT
SECTION PLAT

_____ Ft. from N. Line

330 Ft. from S. Line

_____ Ft. from E. Line

330 Ft. from W. Line

Ellis County

Location _____

Rig up _____

Drilling and Remarks:

R U R

RECORD

Cased _____ in., _____ ft.

Sand _____

Gas _____

Oil _____

Total Depth _____

PRODUCTION

1st 24 hrs. Nat. _____

1st 24 hrs. after shot _____

Gas _____ Cu. Ft.

Dry Hole _____

Abandoned _____

Date

OCT 12 1949

19

S. J. LEWIS

Scout

Map No. _____ Sec. 18 Twp. 15 R. 17WWell No. 1 Leiker

_____ Alpine Oil & Royalty _____ Company

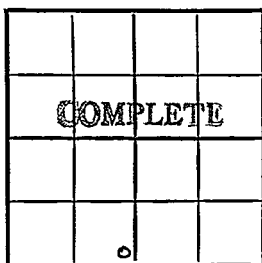
SE SW _____ Contractor

E. L. 1998
SECTION PLAT

_____ Ft. from N. Line

330 _____ Ft. from S. Line

_____ Ft. from E. Line

330 _____ Ft. from W. Line

Ellis County

RECORD

Location _____

Cased _____ in., _____ ft.

Rig up _____

Sand _____

Drilling and Remarks:

Gas _____

8" @ 1156

Oil _____

*5" @ 3571*Total Depth 3585*PP 152 BOPD**5% WTR**Gr 32.1*

PRODUCTION

1st 24 hrs. Nat. _____

1st 24 hrs. after shot _____

Gas _____ Cu. Ft.

Dry Hole _____

Abandoned _____

Date

JAN 11 1950 19

J. E. TYRA

Scout

Arch 1150

Josh 2994

Rob 3248

Lane 3297

Art 3569

JAN 16 1950

Scout Cards

Land Small Map

Land Wall Map

Tracings

France Map

Pierce Map

Misc.