
FORM 51 25M 8-50 WESTERN Ellis KANSAS

Section 18 Township 15 Range 17W

Well No. #1 Stecklein

Company Lindas Oil

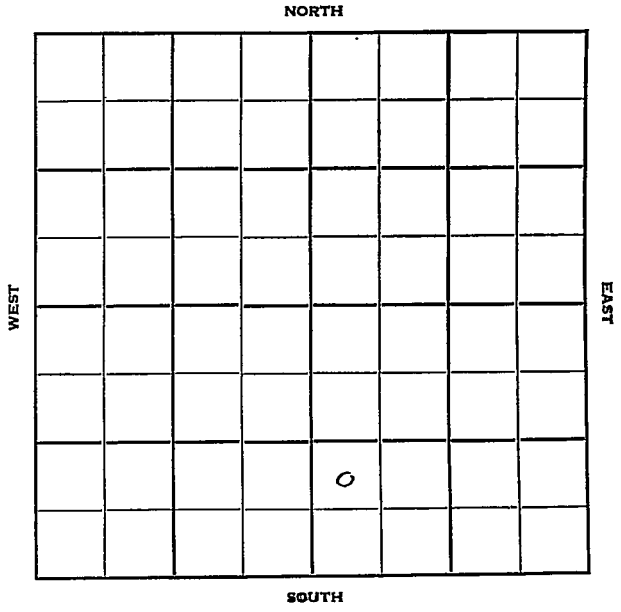

FORM 252-B
10M 8-51 TPCO.

Ellis

KANSAS ✓

Sec. 18 Twp. 15 R. 17W

Well No. #1 Stecklein Farm

Lindas Oil Company

Lindas Oil Contractor
Wheatland


990 Ft. from N. Line

Ft. from S. Line

Ft. from E. Line

330 Ft. from W. Line

NW SW SE

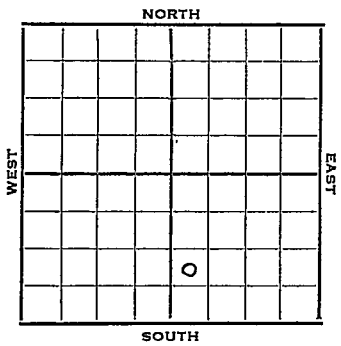

1952	Elev. 1991' REPORT
8/20	Spud 8-18-52 8" @ 912'
8/27	Heeb. 3228 Lans. 3277 DST 3287-3322 1 hr. 60' O&GCM 1110# Drlg. 3415
9/3	Arb. 3547 RTD 3550 5" @ 3548' Schl. Gamma-Ray
9/10	DD 3553' 1000`A S/5 BOPH for 10 hrs. tubing & rods.
9/17	NR
9/24	Spud 8-18-52 Oil Well TD 3553' 8" @ 912 Heeb. 3228 Lans. 3277 DST 3287-3322' open 1 hr. rec. 60' O&GCM 1110# Arb. 3547 TD 3550 5" @ 3548' DD 3553 1000 A S/ 5 boph Comp. 85 bopd

COMPLETED

FORM 275 FOR SALE BY KANSAS BLUE PRINT CO


County Ellis State Kansas

Sec. 18 (Blk. Twp.) 15 (Sur. Rge.) 17W Map No.

Operator Lindas O.I

Well No. 1 Farm Stecklein

Elev. Location NW SW SE

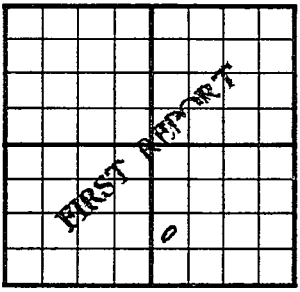

990 Ft. From S Line SE

330 Ft. From W Line Quarter

1st. Report AUG 20 1952

Completion

Remarks

Lindas Oil - Contr.

Spudding Date 8-18-52

Drlg. Data Wheatland

8" @ 912

J. G. McGEHEE

FORM 275 FOR SALE BY KANSAS BLUE PRINT CO.


County Ellis State Kansas

Sec. 18 (Blk. Twp.) 15 (Sur. Rge.) 17W Map No.

Operator Lindas Oil

Well No. 1 Farm Stecklein

Elev. 1991 Location NW SW SE

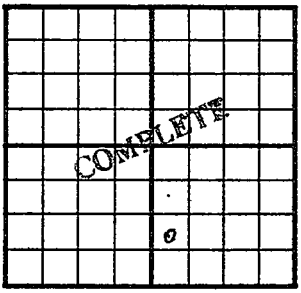

990 Ft. From S Line SE

330 Ft. From W Line Quarter

1st. Report

Completion SEP 2 4 1952

Remarks Wheatland Pool

Lindas Oil - Contr.

Spudding Date 8-18-52

Drlg. Data Oil well TD 3553

8" @ 912 Heeb. 3228 Lans. 3277

DST 3287-3322 open. 1 hr. Rec. 60' o &

gcm 1110# Arb. 3547 TD 3550

5" @ 3548 DD 3553 1000 A S/ 5 boph

Comp. 85 bopd

J. G. McGEHEE