

DX 78-1 Ellis

KANSAS

Section 18 Township 15 Range 17W

Well No. #6 Stecklein

Company Lindas Oil Petroleum Management

NORTH

WEST

EAST

					0		

SOUTH

Ellis

KANSAS

SEC.	TWP.	R.
18	15	17W

WELL NO.

#6 Stecklein

FARM

COMPANY

~~Lindas Oil~~ PETROLEUM MANAGEMENT

CONTRACTOR

K&E Drlg.

_____ Ft. from N. Line

990


_____ Ft. from S. Line

_____ Ft. from E. Line

990

_____ Ft. from W. Line

NE SW SE

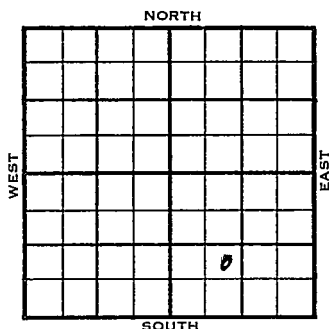

	ELEVATION	REPORT
1954	1989'	
11/11	M I R	
12/1	Oil Well	
	TD 3565'	
	8-5/8" @ 1150'	
	Heeb. 3219', Tor. 3237', Lans. 3266'	
	DST #3271-3330', opn 1 hr., gas in 45"	
	rec. 1560' gassy oil, 920#	
	DST 3333-70', opn 1 hr., rec. XXXX	
	120' OCM, 60' MO, 60' OM, 1050#	
	DST 3410-50', opn 1 hr., rec. 70' mud,	
	0#	
	Arb. 3554'	
	TD 3557'	
	5" @ 3555'	
	DD 3563', 500A	
	DD 3565', FU 1600' oil 48 hrs.	
	Hole Caving - PB 3557'	
	CO to 3560' - S/ 3-1/3 boph	
	Comp. 25 bopd	

COMPLETED

FABEN GILSTRÆ

Kansas

Map No. _____ Sec. 18 Twp. 15 R. 17WWell No. 6 Stecklein

Petroleum Management

Company

CORRECTION

Contractor

NE SW SE

SECTION PLAT

_____ Ft. from N. Line

990

Ft. from S. Line

_____ Ft. from E. Line

990

Ft. from W. Line

		o	

Ellis County

Location _____

Rig up _____

Drilling and Remarks:

Reported

Lindas Oil

RECORD

Cased _____ in., _____ ft.

Sand _____

Gas _____

Oil _____

Total Depth _____

PRODUCTION

1st 24 hrs. Nat. _____

1st 24 hrs. after shot _____

Gas _____ Cu. Ft.

Dry Hole _____

Abandoned _____

Date

NOV 17 1954

FABEN GILSTRAP

19

Scout

County Ellis State Kansas

Sec. 18 (Blk. Twp.) 15 (Sur. Rge.) 17W Map No.

Operator Petroleum Management

Well No. 6 Farm Stecklein

Elev.	1989	Location	NE SW SE
-------	------	----------	----------

COMPLETE

990Ft. From S Line SE

990Ft. From W Line Quarter

1st. Report

Completion DEC 1 1954

Remarks

K & E Drlg. - Contr.

Spudding Date

Drig. Data Oil well TD 3565

8 5/8" @ 1150 Heeb. 3219 Tor. 3237

Lans. 3266 DST 3271-3330 open 1 hr.

gas in 45 min. Rec. 1560' gassy oil 920#

DST 3333-70 open 1 hr. Rec. 120' ocm

60' mo 60' om 1050# DST 3410-50

open 1 hr. Rec. 70' mud 0# Arb. 3554

TD 3557 5" @ 3555 DD 3563 500 A

DD 3565 FU 1600' oil 48 hr. PB 3557

CO to 3560- S/ 3 1/3 boph

Comp. 25 bopd

FABEN ON STRAD

TADEN GILSTRAP

FABEN GILSTRAP