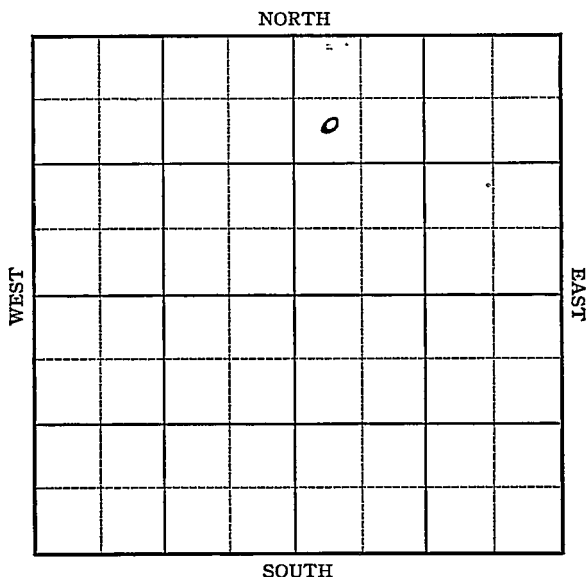


KANSAS

Cowley

FORM 51 5M 4-41 PETROL


Section 29 Township 34 Range 3-EWell No. #1 Schurtz (Shurtz)Company Sinclair Prairie

Sec. 29 Twp. 34 R. 3-EWell No. #1 Schurtz FarmSinclair-Prairie Company

(Misc.)

990 Ft. from N. Line Ft. from S. Line Ft. from E. Line330 Ft. from W. Line

Elev. 1143

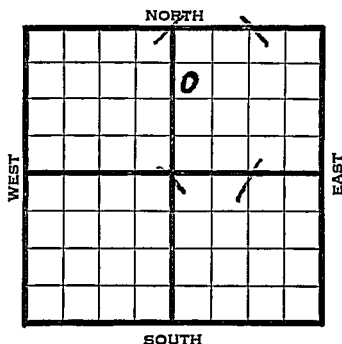

1941	REPORT
6/25	10" - 113' WOC.
7/3	Drlg. 1665'
7/10	Topeka 1520' K.C. 26525 ²⁶⁶⁵
	Drlg. 2872'
7/17	K.C. 2665' (Corrected)
	7" - 3337' T.D. 3346' RUST.
7/24	Bart 3336' 7" @ 3337' TD 3391' Flow
	17½ oil in 6 hrs.
7/31	" " " "
8/7	" " " "
8/13	Bart. 3336'
	Lans. 2665 (Corr).
	7" - 3337'
	40 qts. 3373-90
	T.D. 3391'
	Pot. 389 oil
	Grav. 36.
	COMPLETED

Map No. 1 Sec. 29 Twp. 34 R. 3EWell No. 1 SchurtzSinclair Prairie Company

Contractor

FIRST REPORT

SW NW NE


990 Ft. from N. Line

Ft. from S. Line

Ft. from E. Line

330 Ft. from W. Line

SECTION PLAT

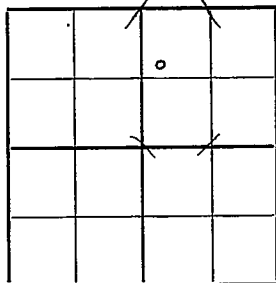

MISCELLANEOUS

Location _____

Rig up _____

Drilling and Remarks:

10" - 113Woc

RECORD

Cased _____ in., _____ ft.

Sand _____

Gas _____

Oil _____

Total Depth _____

PRODUCTION

1st 24 hrs. Nat. _____

1st 24 hrs. after shot _____

Gas _____ Cu. Ft.

Dry Hole _____

Abandoned _____

Date

JUN 25 1941 19 S I LEWIS Scout


Map No. / Sec. 29 Twp. 34 R. 3EWell No. 1 SchurtzSinclair Prairie Company**COMPLETED**

Contractor

SW NW NE

990 Ft. from N. Line Ft. from S. Line Ft. from E. Line330 Ft. from W. Line

SECTION PLAT

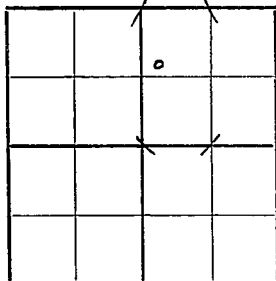

MISCELLANEOUS

Location Rig up

Drilling and Remarks:

East 3336
Land 2665 (con)

*7" 3337**40 ft 3373-90**Pet. 389 oil*

RECORD

Cased in., ft.Sand Gas Oil Total Depth 3391

PRODUCTION

1st 24 hrs. Nat. 1st 24 hrs. after shot Gas Cu. Ft.Dry Hole Abandoned

Date

8/13/41

19

36 grad
S. J. LEWIS Scout