

KANSAS


Cowley

FORM 51 5M 4-41 PETROL

Section 29 Township 34 Range 3-E


Well No. #2 Shurtz

Company Sinclair-Prairie

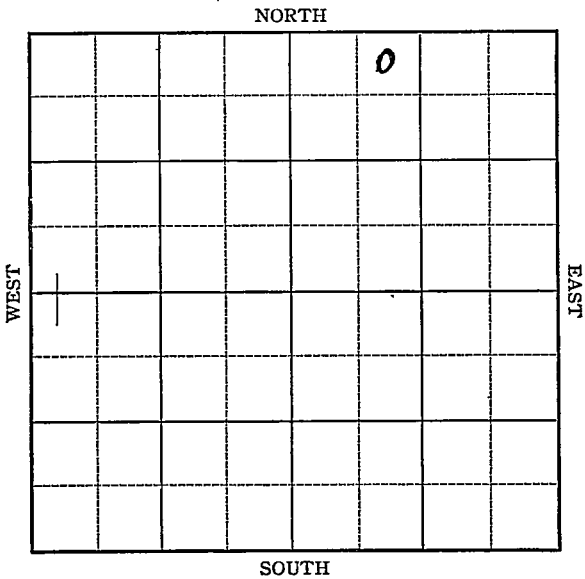

KANSAS**Cowley**Sec. 29 Twp. 34 R. 3-EWell No. #2 Shurtz FarmSinclair-Prairie Company

(Misc.)

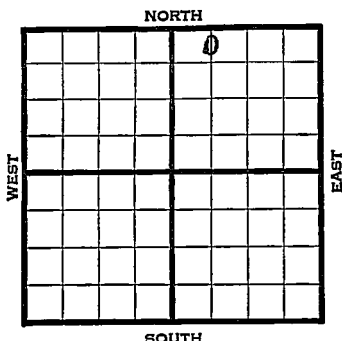330 Ft. from N. Line Ft. from S. Line Ft. from E. Line660 Ft. from W. Line

Elev. 1141

1941	REPORT
9/24	Location
10/2	Rotary.
10/9	10" - 118' Drlg. 2595'
10/16	Drlg. 2720'
10/23	7" - 3344' RUST.
10/30	Bart. 3363' T.D. 3395'
	Shot 60 qts. 3370-94'
	Swab & flow 165 oil 24 hours.
11/6	" " " "
11/13	" " " "
11/19	Bart. 3363'
	7" - 3351'
	T.D. 3395'
	Shot 60 qts. 3370-94'
	Potential 297 bbls., pump.
	38. Gravity
	COMPLETED

Map No. K-1 Sec. 29 Twp. 34 R. 3EWell No. 2 ShurtzSinclair-Prairie CompanyFIRST REPORT Contractor

SECTION PLAT

NE NW NE

330 Ft. from N. Line Ft. from S. Line Ft. from E. Line660 Ft. from W. Line

MISCELLANEOUS

Location Rig up

Drilling and Remarks:

RECORD

Cased in., ft.Sand Gas Oil Total Depth

PRODUCTION

1st 24 hrs. Nat. 1st 24 hrs. after shot Gas Cu. Ft.Dry Hole Abandoned

Date

SEP 24 1941

19

S. J. LEWIS Scout

Cowley

KANSAS

Map No. K-1 Sec. 29 Twp. 34 R. 3EWell No. 2 ShurtzSinclair-Prairie CompanyCOMPLETED Contractor

NE NW NE

SECTION PLAT

330 Ft. from N. Line Ft. from S. Line Ft. from E. Line660 Ft. from W. Line

MISCELLANEOUS

RECORD

Location Cased in., ft.Rig up Sand

Drilling and Remarks:

Gas *Bar 43363*Oil Total Depth 3275*7" @ 3201*

PRODUCTION

*Log to 3370-94*1st 24 hrs. Nat. *Pump 297 ~~25~~*1st 24 hrs. after shot Gas Cu. Ft.Dry Hole Abandoned *35° Gr*

Date

NOV 19 1941

19

S. J. LEWIS

Scout