

Map No. _____ Sec. 19 Twp. 28 R. 4Well No. J. Crabb Farm _____Wichita-Tulsa Company _____

NORTH

WEST

EAST



SOUTH

Location _____

Rig Up _____

Drilling Remarks:

Drilling Remarks:

RECORD

Cased _____ in _____ Ft.

Sand _____

Gas _____

Oil _____

Total Depth _____

PRODUCTION

1st 24 hrs. Nat. _____

1st 24 hrs. after shot _____


Gas _____ Cu. Ft.

Dry Hole _____

Abandoned _____

Map No. _____ Sec. 19 Twp. 28 R. 4
 Well No. 1 Crabbe Farm _____
Wishite - Tulsa Company _____

NORTH

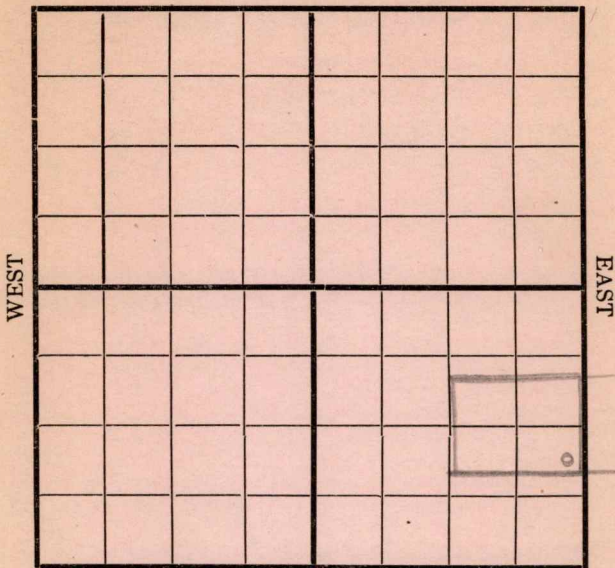

SOUTH

Location _____
 Rig Up ☒
 Drilling and remarks _____

RECORD

Cased _____ in. _____ Ft.
 Sand _____
 Gas _____
 Oil _____
 Total Depth _____

PRODUCTION


1st 24 hrs. Nat. _____
 1st 24 hrs. after shot _____
 Gas _____ Cu. Ft.
 Dry Hole _____
 Abandoned _____

Date 1/29, 1917 Crabbe Scout

Map No. _____ Sec. 19 Twp. 28 R. 4
 Well No. Crab Farm _____
Wright-Tulsa Company

NORTH

WEST

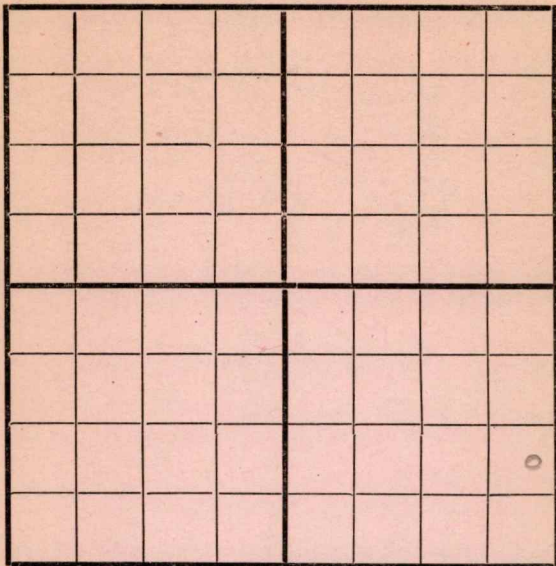

EAST

SOUTH

Location _____
 Rig Up _____
 Drilling and remarks _____

RECORD

Cased _____ in. _____ Ft.
 Sand _____
 Gas _____
 Oil _____
 Total Depth _____

PRODUCTION

1st 24 hrs. Nat. _____
 1st 24 hrs. after shot _____
 Gas _____ Cu. Ft.
 Dry Hole _____
 Abandoned _____

Date

2/5, 1917 Carly Scout

Map No. _____ Sec. 19 Twp. 28 R. 4
Well No. 1 Crabb Farm _____
Wichita-Tulsa Company

NORTH

WEST

EAST

SOUTH

Location _____
 Rig Up _____
 Drilling and remarks _____

RECORD


Cased _____ in. _____ Ft.
 Sand _____
 Gas _____
 Oil _____
 Total Depth _____

PRODUCTION

1st 24 hrs. Nat.
1st 24 hrs. after shot
Gas Cu. Ft.
Dry Hole
Abandoned

Date Feb 7 1917 Conder Scout

Map No. _____ Sec. 19 Twp. 28 R. 4
 NORTH

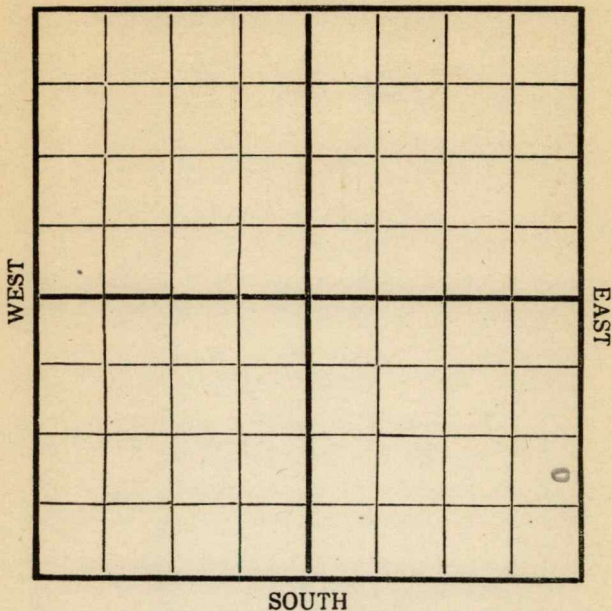

Location _____
 Rig Up _____
 Drilling and remarks

Spending

RECORD

Cased _____ in. _____ Ft.
 Sand _____
 Gas _____
 Oil _____
 Total Depth _____

PRODUCTION


1st 24 hrs. Nat. _____
 1st 24 hrs. after shot _____
 Gas _____ Cu. Ft.
 Dry Hole _____
 Abandoned _____

Date 2/9, 1917 Cord Scout

Map No. _____ Sec. 19 Twp. 28 R. 4

NORTH

WEST

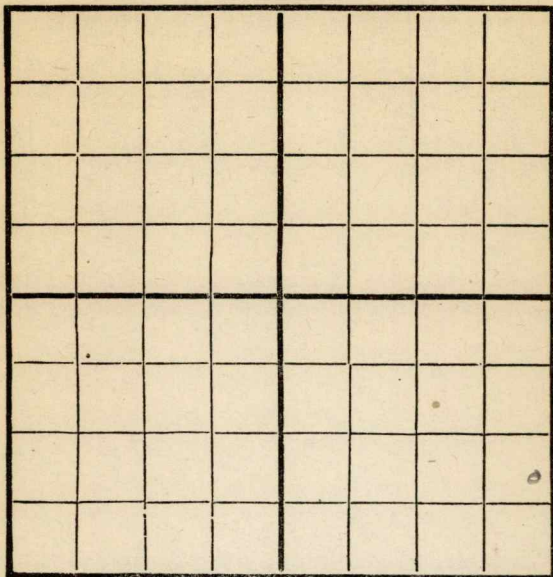

EAST

SOUTH

Location _____
 Rig Up _____
 Drilling and remarks

1380

RECORD

Cased _____ in. _____ Ft.
 Sand _____
 Gas _____
 Oil _____
 Total Depth _____

PRODUCTION

1st 24 hrs. Nat. _____
 First 24 hrs. after shot _____
 Gas _____ Cu. Ft.
 Dry Hole _____
 Abandoned _____

Date

2/26, 1912 Carley Scout

Map No. _____ Sec. 19 Twp. 28 R. 4Well No. 1 Crabb FarmWichita-Tulsa Company

NORTH

WEST

EAST

SOUTH

REMARKS:

1410'

Date

3/5, 1917 Crabb Scout

Map No. _____ Sec. 19 Twp. 28 R. 4
 Well No. 1 Crab Farm _____
Mohita Tulsa Company _____

NORTH

WEST

EAST

SOUTH

Location _____

Rig Up _____

Drilling and remarks

1910'

RECORD

Cased _____ in. _____ Ft.

Sand _____

Gas _____

Oil _____

Total Depth _____

PRODUCTION

1st 24 hrs. Nat. _____

1st 24 hrs. after shot _____

Gas _____ Cu. Ft.

Dry Hole _____

Abandoned _____

Date

3/2, 1911 early Scout

Map No. _____ Sec. 19 Twp. 28 R. 4
 Well No. 1 Crabb Farm _____
Wichita-Tulsa Company _____

NORTH

WEST

EAST

SOUTH

Location _____

Rig Up _____

Drilling and remarks

2020'

RECORD

Cased _____ in. _____ Ft.

Sand _____

Gas _____

Oil _____

Total Depth _____

PRODUCTION

1st 24 hrs. Nat. _____

1st 24 hrs. after shot _____

Gas _____ Cu. Ft.

Dry Hole _____

Abandoned _____

Date

3/191917Condeff

Scout

Map No. _____ Sec. 19 Twp. 28 R. 4Well No. 1 Crabb Farm _____Wabita Tulsa Company _____

NORTH

WEST

EAST

SOUTH

Location _____

Rig Up _____

Drilling and remarks

2335

RECORD

Cased _____ in. _____ Ft.

Sand _____

Gas _____

Oil _____

Total Depth _____

PRODUCTION

1st 24 hrs. Nat. _____

1st 24 hrs. after shot _____

Gas _____ Cu. Ft.

Dry Hole _____

Abandoned _____

Date

3/26, 191 2 _____ Scout

Map No. _____ Sec. 19 Twp. 38 R. 4
 Well No. 1 Crabb Farm _____
Wichita-Tulsa Company _____

NORTH

WEST

EAST

COMPLETED

SOUTH

Location _____
 Rig Up _____
 Drilling and remarks _____

Est at 75'
Bbles

RECORD

Cased _____ in. _____ Ft.
 Sand 2477-2497
 Gas _____
 Oil _____
 Total Depth _____

PRODUCTION

1st 24 hrs. Nat. _____
 First 24 hrs. after shot _____
 Gas _____ Cu. Ft.
 Dry Hole _____
 Abandoned _____

Date

4/4, 191 7 Carby Scout