

KANSAS

FORM 51 5M 10-41 PETROL


Cowley

Section 29 Township 34 Range 3 E

Well No. #3 Shurtz

Company Sinclair-Prairie

Miscellaneous

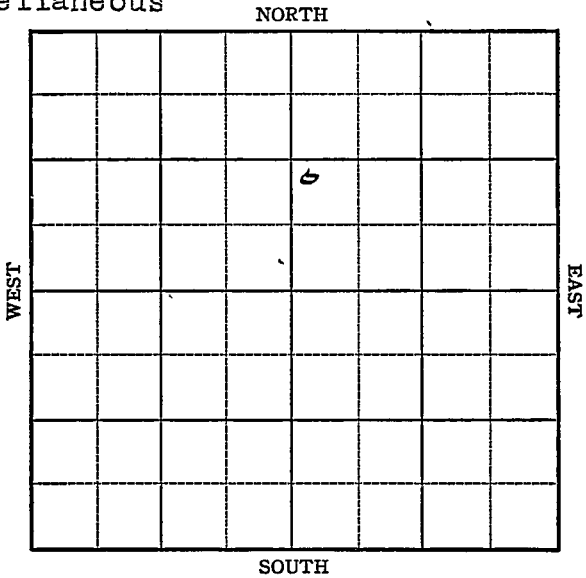

Sec. 29 Twp. 34 R. 3-E

Well No. #3 Shurtz Farm

Sinclair-Prairie Company

(Miscellaneous)


_____ Ft. from N. Line

990 Ft. from S. Line

_____ Ft. from E. Line

330 Ft. from W. Line

Elw. 1133

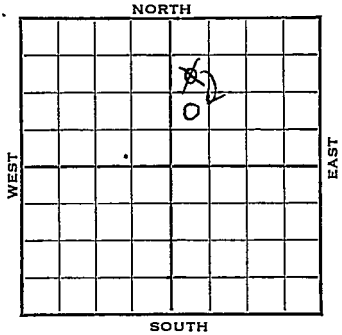

1942

REPORT

- 9/16 Derrick
- 9/23 ~~10/23 XXXXX Drilling 2315X~~ Derrick
- 9/30 Drig. 1046
- 10/7 Drig. 2870'
- 10/14 Layton 2670
KC 2857
Bart 3340
5" @ 3341 TD 3351 Rust.
- 10/21 " " " " "
- 10/28 B. Sand 3380
TD 3381-400' oil 48 hrs
30 qts 3364-80 CD
- 11/11 5" @ 3341
Bart. 3340
T.D. 3381'
30 qts 3364-80
Pump 73 Pot.
Gravity 36.7

COMPLETED

Cowley

KANSAS

Map No. / Sec. 29 Twp. 34 R. 3E

Well No. 3 Shurtz

Sinclair-Prairie Company

FIRST REPORT Contractor

NW SW NE

SECTION PLAT

		o	

 Ft. from N. Line

990 Ft. from S. Line

 Ft. from E. Line

330 Ft. from W. Line

MISCELLANEOUS

Location

Rig up

Drilling and Remarks:

Derrick

RECORD

Cased in., ft.

Sand

Gas

Oil

Total Depth

PRODUCTION

1st 24 hrs. Nat.

1st 24 hrs. after shot

Gas Cu. Ft.

Dry Hole

Abandoned

Date

SEP 16 1942

19

S. J. LEWIS

Scout

KANSAS

Map No. _____ / Sec. 29 Twp. 34 R. 3E

Well No. 3 Shurtz

Sinclair-Prairie Company

COMPLETED Contractor

NW SW NE

SECTION PLAT

_____ Ft. from N. Line

990 Ft. from S. Line

_____ Ft. from E. Line

330 Ft. from W. Line

		6	

MISCELLANEOUS

Location _____

Rig up _____

Drilling and Remarks:

Bar 8340
5" C 8341
30 gal 8344-80
Pump 73 8344

862-52

RECORD

Cased _____ in., _____ ft.

Sand _____

Gas _____

Oil _____

Total Depth 8387

PRODUCTION

1st 24 hrs. Nat. _____

1st 24 hrs. after shot _____

Gas _____ Cu. Ft.

Dry Hole _____

Abandoned _____

Date

NOV 11 1942 19

S. J. LEWIS Scout