

Section 29 Township 34 Range 3E

Well No. #4 Shurtz

Company Sinclair-Prairie

Miscellaneous

NORTH

				0			

WEST

EAST

SOUTH

Sec. 29 Twp. 34 R.

Well No. #4 Shurtz Farm

Sinclair-Prairie Company


Misc.

330 Ft. from N. Line

Ft. from S. Line

Ft. from E. Line

330 Ft. from W. Line

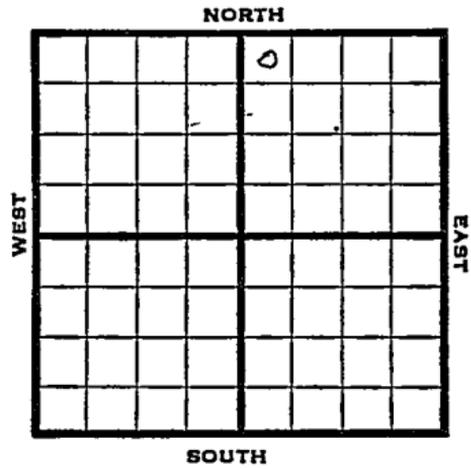

NW NE

1948 Eli 1139' REPORT

- 4/7 Location
- 4/14 "
- 4/21 "
- 4/28 "
- 5/5 10" @ 125'  
Drlg. 446'
- 5/12 SD
- 5/19 "
- 5/26 Drlg. 1250'
- 6/1 Drlg. 2860'
- 6/9 "
- 6/16 "
- 6/23 "
- 6/29 "
- 7/14 TD 3385'  
Bart 3351'  
Miss 3384'  
7" @ 3342'  
Pump 50 Oil Pot  
39° Gr.  
Comp.

**COMPLETED**

Map No. \_\_\_\_\_ Sec. 29 Twp. 34 R. 3E

Well No. 4 Shurtz

Sinclair-Prairie Company

**IRST REPORT** Contractor

NW NE

SECTION PLAT

330 Ft. from N. Line

\_\_\_\_\_ Ft. from S. Line

\_\_\_\_\_ Ft. from E. Line

330 Ft. from W. Line

		o	

Cowlev County

Location X

Rig up \_\_\_\_\_

Drilling and Remarks:

RECORD

Cased \_\_\_\_\_ in., \_\_\_\_\_ ft.

Sand \_\_\_\_\_

Gas \_\_\_\_\_

Oil \_\_\_\_\_

Total Depth \_\_\_\_\_

PRODUCTION

1st 24 hrs. Nat. \_\_\_\_\_

1st 24 hrs. after shot \_\_\_\_\_

Gas \_\_\_\_\_ Cu. Ft.

Dry Hole \_\_\_\_\_

Abandoned \_\_\_\_\_

Date

APR 7 1948

19

S. J. LEWIS

Scout

Map No.        /        Sec. 29 Twp. 34 R. 3E

Well No. 4 Shurtz

Sinclair-Prairie Company  
**COMPLETE**

Contractor

NW NE

*E 1, 139*  
SECTION PLAT

330 Ft. from N. Line

       Ft. from S. Line

       Ft. from E. Line

330 Ft. from W. Line

		0	

Cowley County

Location       

Rig up       

Drilling and Remarks:

*Bar 83351*

*Alia 3384*

*7" 03942*

*Pump 50 oil*

*89 1/2*

RECORD

Cased        in.,        ft.

Sand       

Gas       

Oil        ✓

Total Depth 3385

PRODUCTION

1st 24 hrs. Nat.       

1st 24 hrs. after shot       

Gas        Cu. Ft.

Dry Hole       

Abandoned       

Date

JUL 14 1948

19

S. J. LEWIS Scout

