


KANSAS

Section 27 Township 15 Range 14W

Well No. 1 Dietz

Company Don Ingling

Trapp Pool
NORTH

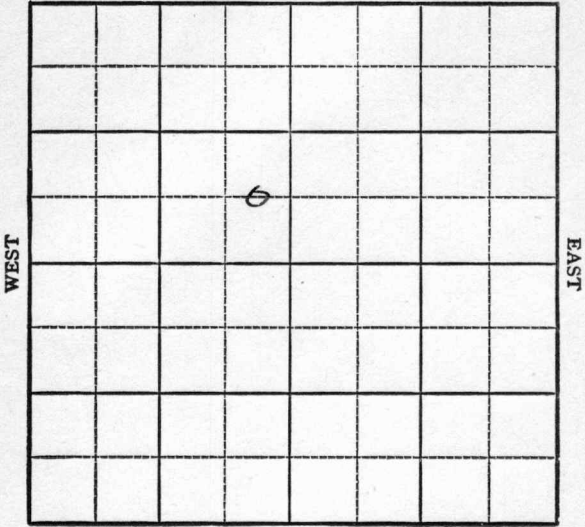

SOUTH

KANSAS

Russell

Sec. 27 Twp. 15 R. 14W

Well No. #1 Dietz Farm

Don Ingling

Company

Trapp Pool


Ft. from N. Line

660' Ft. from S. Line

330' Ft. from E. Line

Ft. from W. Line

C E L SE NW

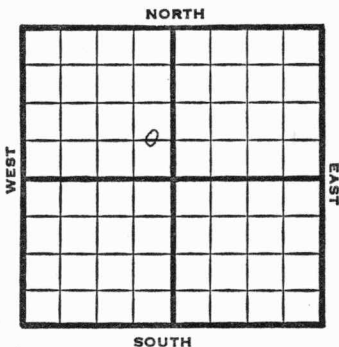

1948

Elev 1906'

R E P O R T

12/15
12/22
12/29

8" @ 250'
Drlg 2705'
Drlg 3324'

1949

1/12

TD 3377'
Arb. 3357'
Aband.

ABANDONED

Map No. _____ Sec. 27 Twp. 15 R. 14W

Well No. 1 Dietz

Don Ingling Company

FIRST REPORT Contractor

C E L SE NW

SECTION PLAT

_____ Ft. from N. Line

660 Ft. from S. Line

380 Ft. from E. Line

_____ Ft. from W. Line

Russell County

Location _____

Rig up _____

Drilling and Remarks:

8" @ 250

RECORD

Cased _____ in., _____ ft.

Sand _____

Gas _____

Oil _____

Total Depth _____

PRODUCTION

1st 24 hrs. Nat. _____

1st 24 hrs. after shot _____

Gas _____ Cu. Ft.

Dry Hole _____

Abandoned _____

Date


DEC 15 1948

19

S. J. LEWIS

Scout

Kansas

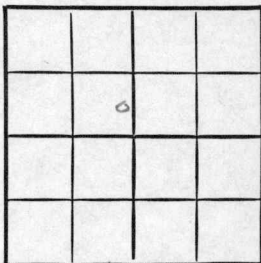Map No. 73 Sec. 27 Twp. 15 R. 14WWell No. 1 DietzDon Ingling
ABANDONED CompanyC E L SE NW Contractor
E. 1906
SECTION PLAT Ft. from N. Line660 Ft. from S. Line330 Ft. from E. Line Ft. from W. Line

Russell County

Location Rig up

Drilling and Remarks:

Cur 3357**RECORD**Cased in., ft.Sand Gas Oil Total Depth 3377**PRODUCTION**1st 24 hrs. Nat. 1st 24 hrs. after shot Gas Cu. Ft.Dry Hole Abandoned

Date

JAN 12 1949

19

S. J. LEWIS

Scout