


Map No. KANSAS Sec. 27 Twp. 15 R. 14W
 Well No. 1-Karot Farm _____
Massau Pit Company _____

NORTH

WEST

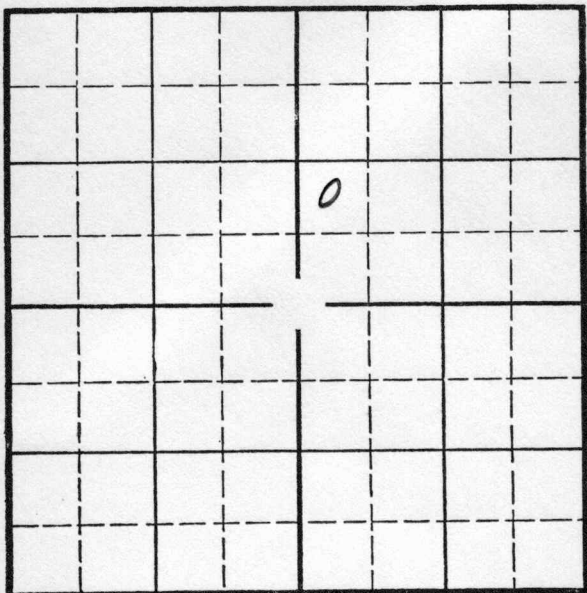

EAST

SOUTH

Location _____
 Drilling Remarks _____

Rig Up _____
 Drilling Remarks _____

RECORD

Cased _____ in. _____ ft.
 Sand _____
 Gas _____
 Oil _____
 Total Depth _____

PRODUCTION

1st 24 hrs. Nat. _____
 1st 24 hrs. after shot _____
 Gas _____ cu. ft. _____
 Dry Hole _____
 Abandoned _____

Russell

Map No. KANSAS Sec. 27 Twp. 15 R. 14^W

Well No. 1-Karst Farm
Massan Pst. Company


 Ft. from N. Line

990 Ft. from S. Line

 Ft. from E. Line

330 Ft. from W. Line

Elev. 1900

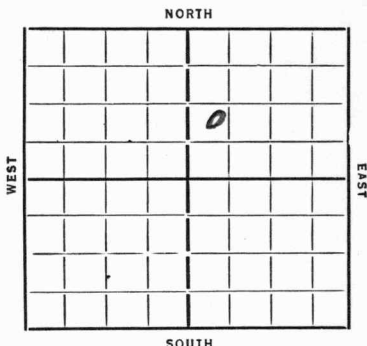

Date 1935 REPORT

6/5 Moving
6/13 Rog
6/20 Rgn
6/28 — 7/3 —
7/4 Rig
7/18 Sil 225
8/8 " 1825
8/5 8" 2205 CO.
8/22 2315 UR 8"
8/29 2565 TD UR 8"
9/6 Sil 2725
10/3 6" 3291 Sil 3315-18
1000' 3 hrs 50.
10/10 —
10/24 Sil 3315
TD 3319
287 Blw.

COMPLETED

Map No. 73 Sec. 27 Twp. 15 R. 14WWell No. 1-KarstNassan pit Company

Contractor

FIRST REPORTS

SECTION PLAT

Ft. from N. Line

990 Ft. from S. Line

Ft. from E. Line

330 Ft. from W. Line

		0	

Location

Rig up

Drilling and Remarks:

Moving

RECORD

Cased in., ft.

Sand

Gas

Oil

Total Depth

PRODUCTION

1st 24 hrs. Nat.

1st 24 hrs. after shot

Gas Cu. Ft.

Dry Hole

Abandoned

Date

6-5-35 192 Scout

ORVAL MANNSCHECK

Map No. 73 Sec. 27 Twp. 15 R. 14 ^NWell No. 1-KarstNassau Pet Company

Contractor

COMPLETED

SECTION PLAT

		0	

Ft. from N. Line

990 Ft. from S. Line

Ft. from E. Line

330 Ft. from W. Line

Location

Rig up

Drilling and Remarks:

287 Bbb

RECORD

Cased in ft.Sand Dil 3315

Gas

Oil

Total Depth 3319

PRODUCTION

1st 24 hrs. Nat.

1st 24 hrs. after shot

Gas Cu. Ft.

Dry Hole

Abandoned

Date

10-24-35 192 Scout

ORVAL MANNSCHECK