


Map No. 1 Sec. 1 Twp. 10 R. 1

Well No. 15442 Farm 11

Company

NORTH

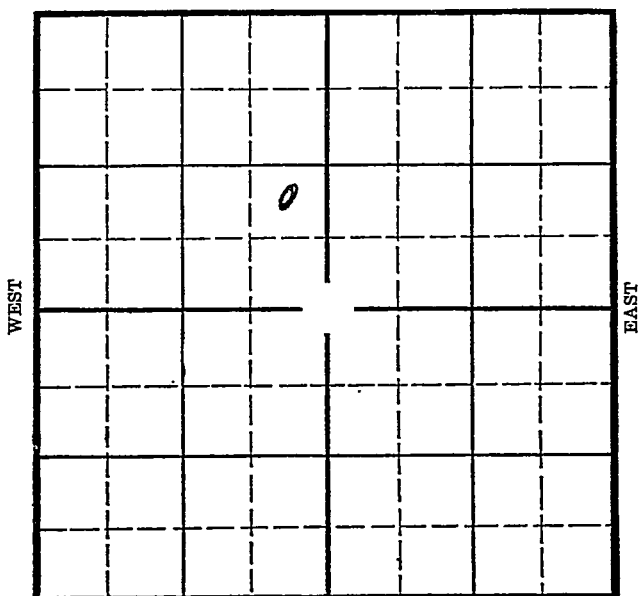

SOUTH

Location _____

Drilling Remarks

Rig Up_____

Drilling Remarks

RECORD

Cased _____ in. _____ ft.

Sand_____

Gas

Oil

Total Depth_____

PRODUCTION

1st 24 hrs. Nat. _____

1st 24 hrs. after shot_____

Gas _____ cu. ft. _____

Dry Hole_____

Abandoned_____

Map No. 27 Sec. 15 Twp. 14W R. Russell
Well No. 1-Karet Farm Barnsdall Oil Company

990 Ft. from N. Line
330 Ft. from S. Line
330 Ft. from E. Line
Ft. from W. Line

NORTH									
SOUTH									

Elev. 1903

Date	REPORT
11/13	Location
11/21	11/29-
11/26	Rig
12/13	Rul
12/19	20" 21 15" 410
12/26	1040 12" 1014
1/2/36	" 2060
1/10	" 2550 10" 2245
1/17	" 2975 8" 2659
1/24	" 3150 8" 3069
1/31	2nd Oil 3326 440
2/7	1000 acid brushed 30 oil & 12 wtr 12 hrs 2000 acid brushed 100 oil & 24 wtr 24 hrs SD
2/12	Oil 3326 TD 3353 2000 acid 185 Bbls Oil S.W.

COMPLETED

KANSAS

Map No. 73 Sec. 27 Twp. 15 R. 14WWell No. 1-KarstBarnsdall oil Company

Contractor

FIRST REPORTS

Ft. from N. Line

990 Ft. from S. Line330 Ft. from E. Line

Ft. from W. Line

SECTION PLAT

	0		

Location ☒

Rig up

Drilling and Remarks:

RECORD

Cased.....in.,ft.

Sand.....

Gas.....

Oil.....

Total Depth.....

PRODUCTION

1st 24 hrs. Nat.....

1st 24 hrs. after shot.....

Gas.....Cu. Ft.

Dry Hole.....

Abandoned.....

Date

11-13-35 192..... **ORVAL MANNSCHRECK** Scout

KANSAS

Map No. 73 Sec. 27 Twp. 15 R. 14WWell No. 1-KarstBarnsall oil Company

Contractor

~~COMPLETE~~

SECTION PLAT

Ft. from N. Line

990 Ft. from S. Line330 Ft. from E. Line

Ft. from W. Line

	0		

Location

Rig up

Drilling and Remarks:

2000 acid185 bbls
oil. S.W.

RECORD

Cased in. ft.Sand oil 3326

Gas

Oil

Total Depth 3353

PRODUCTION

1st 24 hrs. Nat.

1st 24 hrs. after shot

Gas Cu. Ft.

Dry Hole

Abandoned

Date

2-12-36 192Orval M
Saw

Scout