


Map No. _____ Sec. 19 Twp. 28 R. 4Well No. 2-Brabb _____ Farm _____Big Walnut _____ Company _____

NORTH

WEST

EAST

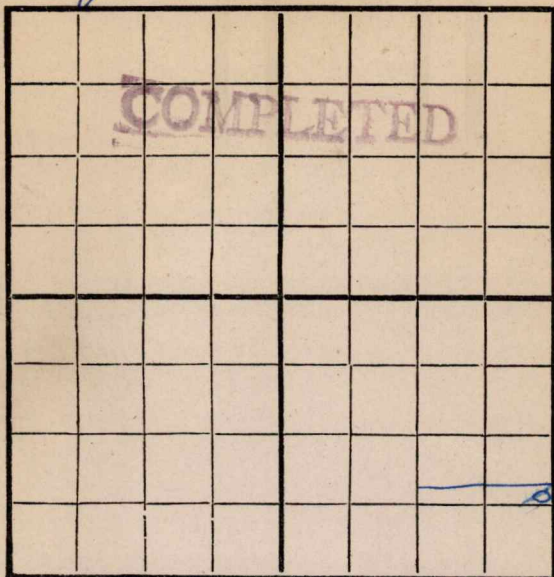

SOUTH

Location _____

Rig Up _____

Drilling Remarks:

Drilling Remarks:

RECORD

PRODUCTION

Cased _____ in _____ Ft.

1st 24 hrs. Nat. _____

Sand _____

1st 24 hrs. after shot _____

Gas _____

Gas _____ Cu. Ft.

Oil _____

Dry Hole _____


Total Depth _____

Abandoned _____

Map No. _____ Sec. 19 Twp. 28 R. 4
 Well No. 2 Crabb Farm _____
Big Walnut Company _____

NORTH

WEST

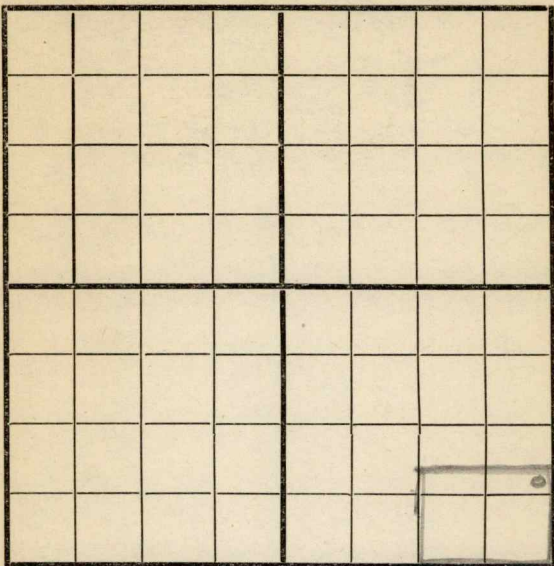

EAST

SOUTH

Location _____
 Rig Up ☒
 Drilling and remarks _____

RECORD

Cased _____ in. _____ Ft.
 Sand _____
 Gas _____
 Oil _____
 Total Depth _____

PRODUCTION


1st 24 hrs. Nat. _____
 1st 24 hrs. after shot _____
 Gas _____ Cu. Ft.
 Dry Hole _____
 Abandoned _____

Date

1/29, 1917 Condy Scout

Map No. _____ Sec. 19 Twp. 28 R. 4Well No. 2 @ Cobb Farm _____Big Walnut Company _____

NORTH

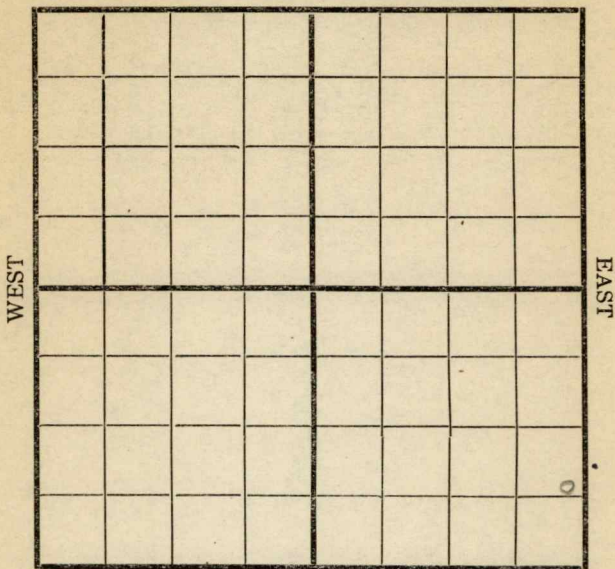

SOUTH

Location _____

Rig Up _____

Drilling and remarks

*Rig Blowed
Down*

RECORD

Cased _____ in. _____ Ft.

Sand _____

Gas _____

Oil _____

Total Depth _____

PRODUCTION

1st 24 hrs. Nat. _____

1st 24 hrs. after shot _____

Gas _____ Cu. Ft.

Dry Hole _____


Abandoned _____

Date

2/5, 1917 Carroll Scout

Map No. _____ Sec. 19 Twp. 28 R. 4
 Well No. 2 Crobb Farm _____
Big Walnut Company _____

NORTH

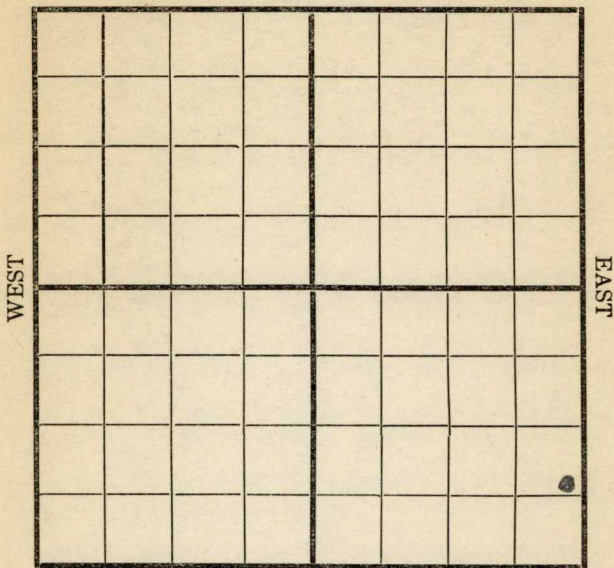

SOUTH

Location _____
 Rig Up ☒ _____
 Drilling and remarks _____

RECORD

Cased _____ in. _____ Ft.
 Sand _____
 Gas _____
 Oil _____
 Total Depth _____

PRODUCTION

1st 24 hrs. Nat. _____
 1st 24 hrs. after shot _____
 Gas _____ Cu. Ft.
 Dry Hole _____
 Abandoned _____

Date 7/2, 1912 Crobb Scout

Map No. _____ Sec. 19 Twp. 38 R. 4
 Well No. 2 Crab _____ Farm

NORTH

WEST

EAST

SOUTH

Location _____
 Rig Up _____
 Drilling and remarks

Spinning

RECORD

Cased _____ in. _____ Ft.
 Sand _____
 Gas _____
 Oil _____
 Total Depth _____

PRODUCTION

1st 24 hrs. Nat. _____
 1st 24 hrs. after shot _____
 Gas _____ Cu. Ft.
 Dry Hole _____
 Abandoned _____

Date


2/19, 1917 Crab _____ Scout

Map No. _____ Sec. 19 Twp. 28 R. 4
 Well No. 2 Crabb Farm _____
Big Walnut Company _____

NORTH

WEST

EAST

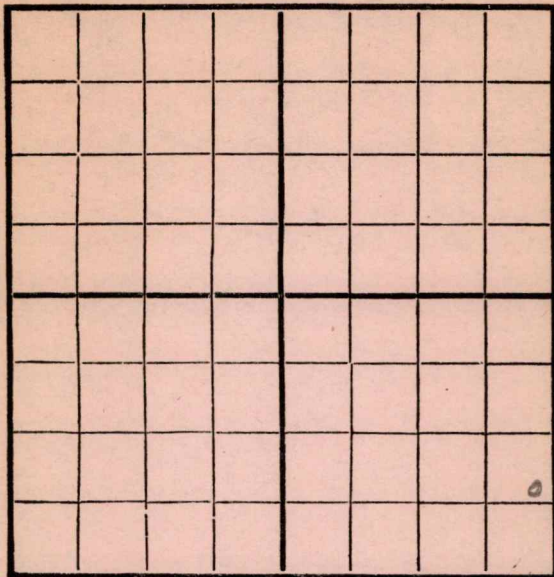

SOUTH

Location _____
 Rig Up _____
 Drilling and remarks _____

650'

RECORD

Cased _____ in. _____ Ft.
 Sand _____
 Gas _____
 Oil _____
 Total Depth _____

PRODUCTION

1st 24 hrs. Nat. _____
 First 24 hrs. after shot _____
 Gas _____ Cu. Ft.
 Dry Hole _____
 Abandoned _____


Date

2/26 1917 Early

Scout

Map No. _____ Sec. 19 Twp. 28 R. 4Well No. 2 Cubb Farm _____Big Walnut Company _____

NORTH

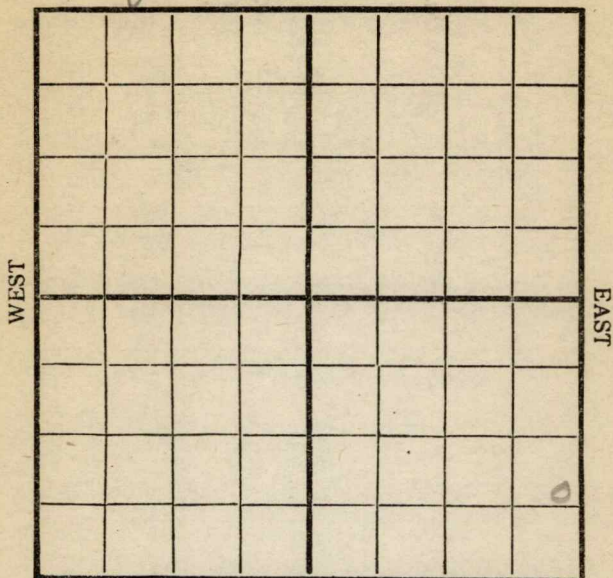

SOUTH

REMARKS:

940

Date

3/5, 191 7

Scout


C. A. [Signature]

Map No. _____ Sec. 19 Twp. 28 R. 4
 Well No. 2 Crabb Farm _____
Big Walnut Company _____

NORTH

WEST

EAST

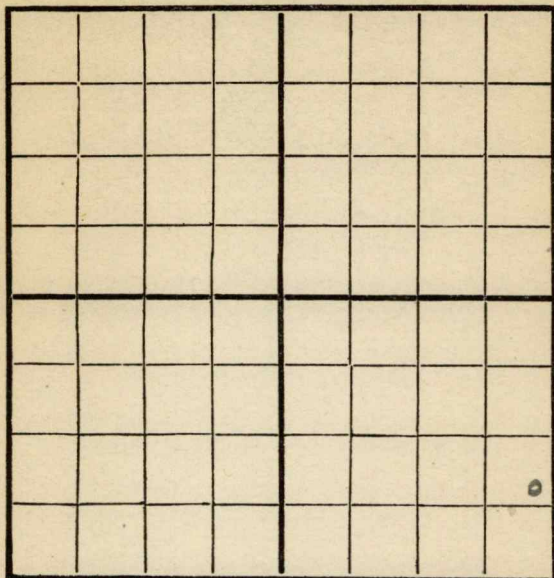

SOUTH

Location _____

Rig Up _____

Drilling and remarks

Shut Down
940

RECORD

Cased _____ in. _____ Ft.

Sand _____

Gas _____

Oil _____

Total Depth _____

PRODUCTION

1st 24 hrs. Nat. _____

1st 24 hrs. after shot _____

Gas _____ Cu. Ft.

Dry Hole _____

Abandoned _____

Date

3/12, 191 *7* *Crabb* Scout

Map No. _____ Sec. 19 Twp. 28 R. 4
 Well No. 2 Crabb Farm _____
Big Walnut Company _____

NORTH

WEST

EAST

SOUTH

Location _____

Rig Up _____

Drilling and remarks

Under Running

RECORD

Cased _____ in. _____ Ft.

Sand _____

Gas _____

Oil _____

Total Depth _____

PRODUCTION

1st 24 hrs. Nat. _____

1st 24 hrs. after shot _____

Gas _____ Cu. Ft.

Dry Hole _____

Abandoned _____

Date

3/19, 1917 Quade Scout

Map No. _____ Sec. 19 Twp. 28 R. 4
 Well No. 20166 Farm _____
Big Walnut Company _____

NORTH

WEST

EAST

SOUTH

Location _____

Rig Up _____

Drilling and remarks

1130'

RECORD

Cased _____ in. _____ Ft.

Sand _____

Gas _____

Oil _____

Total Depth _____

PRODUCTION

1st 24 hrs. Nat. _____

1st 24 hrs. after shot _____

Gas _____ Cu. Ft.

Dry Hole _____

Abandoned _____

Date

3/26, 191 7 Landiff Scout

Map No. _____ Sec. 19 Twp. 28 R. 4
 Well No. 2 Crabbe Farm _____
Big Walnut Company _____

NORTH

WEST

EAST

SOUTH

Location _____
 Rig Up _____
 Drilling and remarks _____

1365'

RECORD

Cased _____ in. _____ Ft.
 Sand _____
 Gas _____
 Oil _____
 Total Depth _____

PRODUCTION


1st 24 hrs. Nat. _____
 First 24 hrs. after shot _____
 Gas _____ Cu. Ft.
 Dry Hole _____
 Abandoned _____

Date

4/4, 191 7 Co. 1st Scout _____

Map No. _____ Sec. 19 Twp. 28 R. 4
 Well No. 2 Crabb Farm _____
Big Walnut Company _____

NORTH

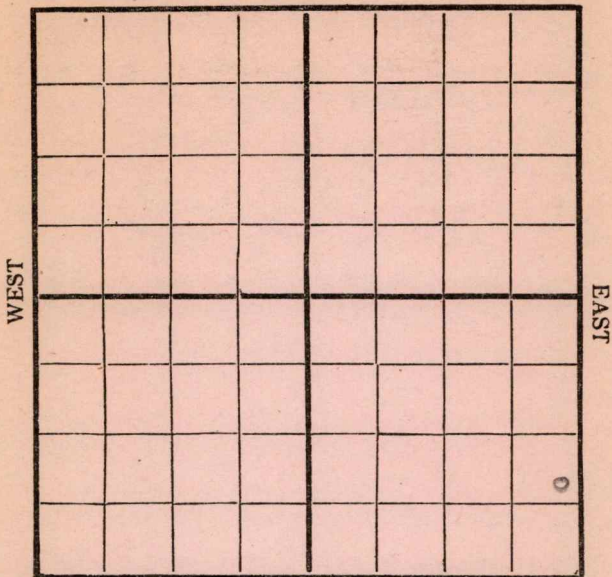

SOUTH

Location _____
 Rig Up _____
 Drilling and remarks _____

1796'

RECORD

Cased _____ in. _____ Ft.
 Sand _____
 Gas _____
 Oil _____
 Total Depth _____

PRODUCTION

1st 24 hrs. Nat. _____
 1st 24 hrs. after shot _____
 Gas _____ Cu. Ft.
 Dry Hole _____
 Abandoned _____

Date


4/10, 1917. Crabb Scout

Map No. _____ Sec. 19 Twp. 38 R. 4
 Well No. 2 Crab Farm _____
Big Walnut Company _____

NORTH

WEST

EAST

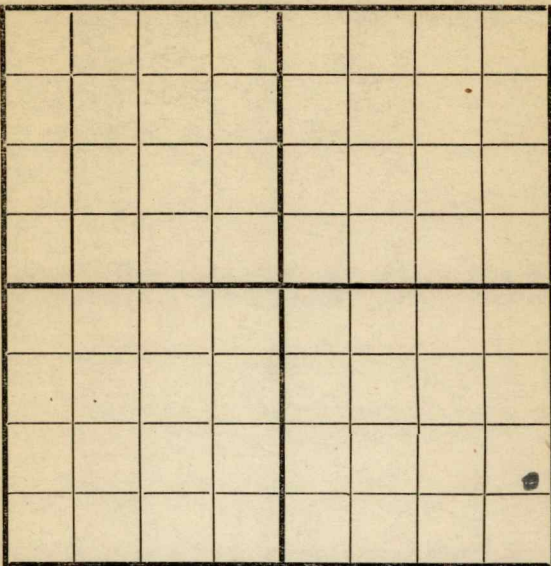

SOUTH

Location _____
 Rig Up _____
 Drilling and remarks _____

9140'

RECORD

Cased _____ in. _____ Ft.
 Sand _____
 Gas _____
 Oil _____
 Total Depth _____

PRODUCTION


1st 24 hrs. Nat. _____
 1st 24 hrs. after shot _____
 Gas _____ Cu. Ft.
 Dry Hole _____
 Abandoned _____

Date

4/17, 1917 Crab Scout

Map No. _____ Sec. 19 Twp. 28 R. 4
 Well No. 3 @ 100 ft Farm _____
Big Walnut Company

NORTH

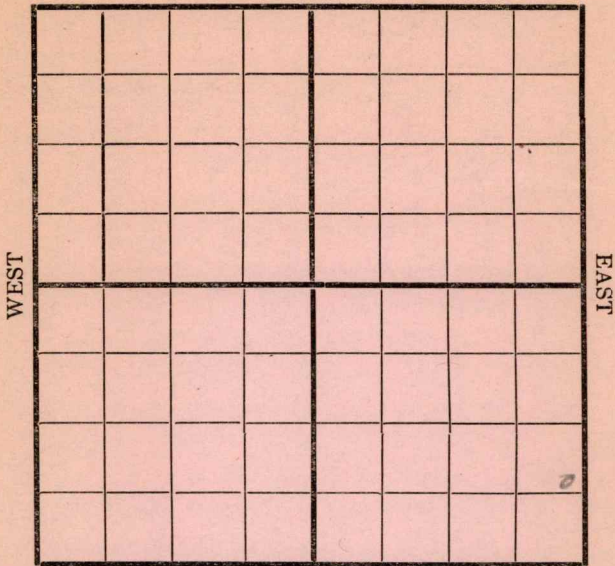

SOUTH

Location _____ Rig Up _____ Drilling and remarks <u>2170'</u>	RECORD
	Cased _____ in. _____ Ft.
	Sand _____
	Gas _____
	Oil _____
	Total Depth _____
	PRODUCTION
	1st 24 hrs. Nat. _____
	1st 24 hrs. after shot _____
	Gas _____ Cu. Ft.
	Dry Hole _____
	Abandoned _____


Date 4/24 1917 Carley Scout

Map No. _____ Sec. 19 Twp. 28 R. 4
 Well No. 2 Crabb Farm _____
Big Walnut Company _____

NORTH

WEST

EAST

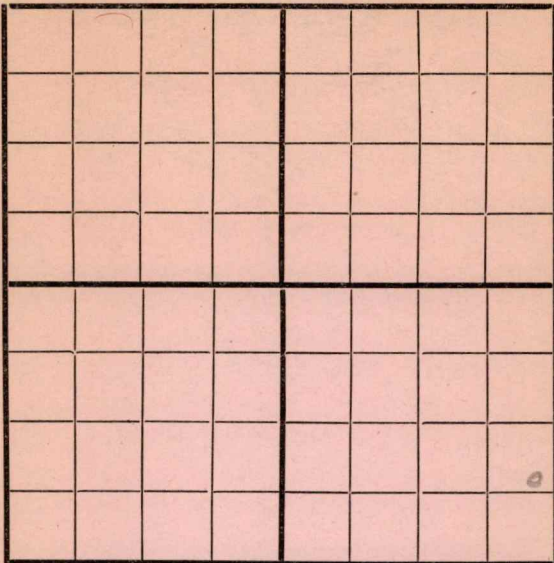

SOUTH

Location _____

Rig Up _____

Drilling and remarks

2360'

RECORD

Cased _____ in. _____ Ft.

Sand _____

Gas _____

Oil _____

Total Depth _____

PRODUCTION

1st 24 hrs. Nat. _____

1st 24 hrs. after shot _____

Gas _____ Cu. Ft.

Dry Hole _____


Abandoned _____

Date

5/2, 1917 Carly Scout

Map No. _____ Sec. 19 Twp. 28 R. 4
 Well No. 2 Crobb _____ Farm
Big Walnut _____ Company

NORTH

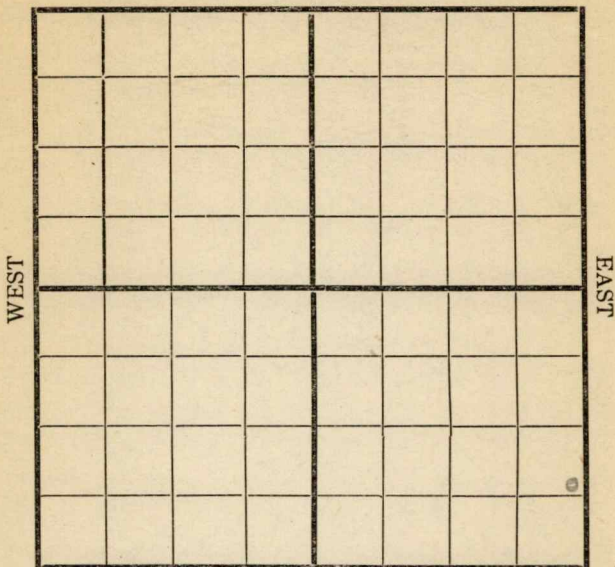

SOUTH

Location _____
 Rig Up _____
 Drilling and remarks _____

RECORD

Cased _____ in. _____ Ft.
 Sand _____
 Gas _____
 Oil _____
 Total Depth _____

PRODUCTION

1st 24 hrs. Nat. _____
 1st 24 hrs. after shot _____
 Gas _____ Cu. Ft.
 Dry Hole _____
 Abandoned _____

Date

5/8, 191 7 Crobb Scout

Map No. _____ Sec. 19 Twp. 28 R. 4
 Well No. 2 Crabb Farm _____
Big Walnut Company _____

NORTH

WEST

EAST

COMPLETED

SOUTH

Location _____

Rig Up _____

Drilling and remarks

*Estimated**at 100 Bls*

RECORD

Cased _____ in. _____ Ft.

Sand 2460-2477

Gas _____

Oil _____

Total Depth _____

PRODUCTION

1st 24 hrs. Nat. _____

1st 24 hrs. after shot _____

Gas _____ Cu. Ft.

Dry Hole _____

Abandoned _____

Date

5/25 191 *7**Crabb* Scout