


NORTH

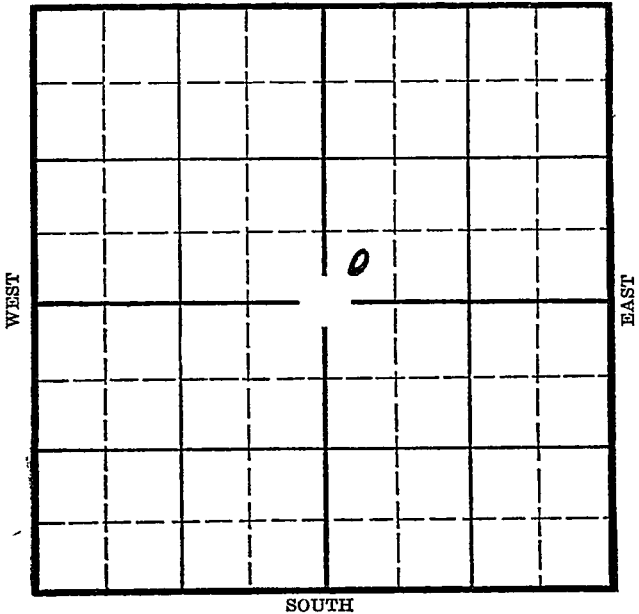

Location_____

Drilling Remarks

Rig Up_____

Drilling Remarks

RECORD

Cased_____in._____ft.

Sand _____

Gas

Oil

Total Depth.....

PRODUCTION

1st 24 hrs. Nat. _____

1st 24 hrs. after shot_____

Gas_____cu. ft._____

Dry Hole_____

Abandoned

Map No. KANSAS Sec. 27 Twp. 15 R. 14W
Well No. 2-Krist Farm
Beardmore sub Company


Ft. from N. Line

330 Ft. from S. Line

Ft. from E. Line

330 Ft. from W. Line

Elev. 1906

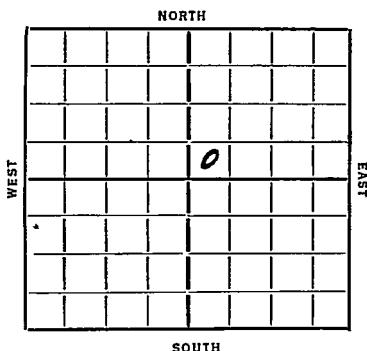

REPORT

1936

3/18 Rig

3/20 --

3/27 Rign.

4/2 [REDACTED]

4/10 Spud.

4/16 10" @ 915' Drlg. 970'

4/23 1840' fishing.

4/30 2285'. U.R. 8".

5/7 Drlg. 2560'.

5/14 Under ream 8" to 2560'.

5/21 2950' fishing.

5/28 Drlg. 3100'.

6/4 Fishing 3265'.

6/11 Sil. 3363'. Pay. 3363'-65'. T.D.
1600' oil in 12 hours. Cleaning out

6/24/36 Sil. 3363'.

1000 gallons of acid.

T.D. 3368'.

253 bbls of oil.

COMPLETED

KANSAS

Map No. 73 Sec. 27 Twp. 15 R. 14 W

Well No. 2-Karst

Beardmore et al Company

Contractor

FIRST REPORT

SECTION PLAT

.....Ft. from N. Line

330 Ft. from S. Line

.....Ft. from E. Line

330 Ft. from W. Line

		0	
*			

Location.....

Rig up.....

Drilling and Remarks:

Rig

RECORD

Cased.....in., ...ft.

Sand.....

Gas.....

Oil.....

Total Depth.....

PRODUCTION

1st 24 hrs. Nat.....

1st 24 hrs. after shot.....

Gas.....Cu. Ft.

Dry Hole.....

Abandoned.....

Date

MAR 19 1936

ORVAL MANNSCHRECK

192.....

Scout

Russell

KANSAS

Map No. 73 Sec. 27 Twp. 15 R. 14WWell No. 2 Kars 8.Beardmore & Co. Company

Contractor

SECTION PLAT

		0	

 Ft. from N. Line320 Ft. from S. Line Ft. from E. Line330 Ft. from W. LineLocation Rig up

Drilling and Remarks:

Sit 3363100 acid253 8 1/2

RECORD

Cased in., ft.Sand Gas Oil Total Depth 3368

PRODUCTION

1st 24 hrs. Nat. 1st 24 hrs. after shot Gas Cu. Ft.Dry Hole Abandoned

Date

JUN 24 1936

19

S. J. LEWIS Scout