


Map No. _____ Sec. 19 Twp. 28 R. 4
 Well No. 2 Crabb Farm _____
Salter et al Company _____

NORTH

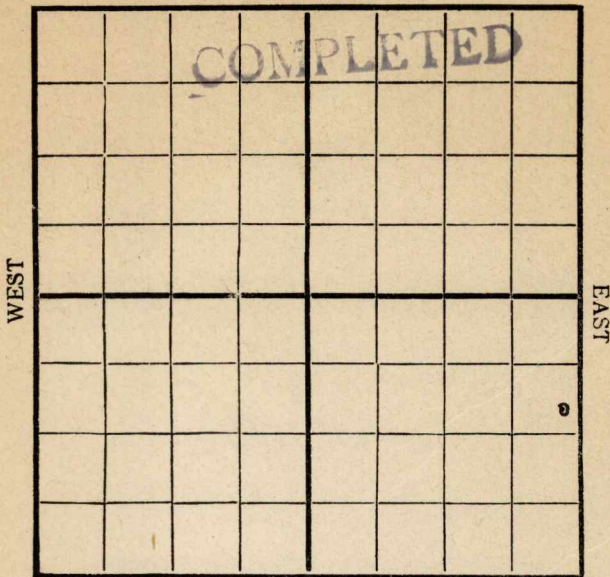

SOUTH

Location _____

Rig Up _____

Drilling Remarks:

Drilling Remarks:

RECORD

PRODUCTION

Cased _____ in _____ Ft.
 Sand _____
 Gas _____
 Oil _____
 Total Depth _____

1st 24 hrs. Nat. _____
 1st 24 hrs. after shot _____
 Gas _____ Cu. Ft.
 Dry Hole _____
 Abandoned _____

Map No. K11 Sec. 19 Twp. 28 R. 4
 Well No. 2C roll Farm
Salter et al Company

NORTH

WEST

EAST

SOUTH

Location _____
 Rig Up _____
 Drilling and remarks _____

RECORD

Cased _____ in. _____ Ft.
 Sand _____
 Gas _____
 Oil _____
 Total Depth _____

FIRST REPORT

PRODUCTION

1st 24 hrs. Nat. _____
 1st 24 hrs. after shot _____
 Gas _____ Cu. Ft.
 Dry Hole _____
 Abandoned _____


Date 4/17, 1917 7 Carbide Scout

Map No. K11 Sec. 19 Twp. 28 R. 4
 Well No. 5000 Farm _____
Salter et al Company _____

NORTH

WEST

EAST

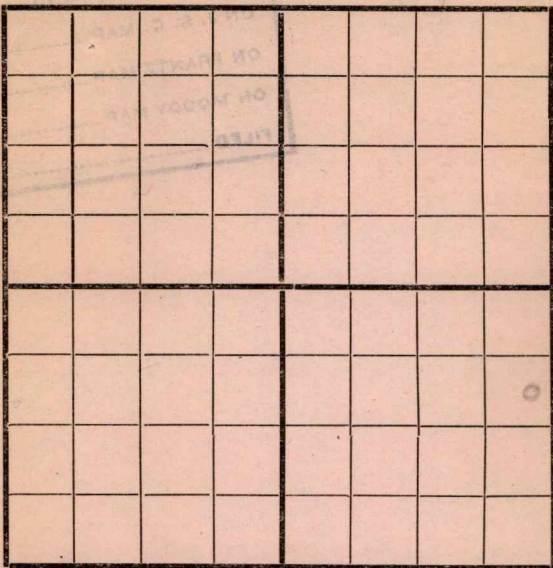

SOUTH

Location _____
 Rig Up _____
 Drilling and remarks _____

RECORD

Cased _____ in. _____ Ft.
 Sand _____
 Gas _____
 Oil _____
 Total Depth _____

PRODUCTION

1st 24 hrs. Nat. _____
 1st 24 hrs. after shot _____
 Gas _____ Cu. Ft.
 Dry Hole _____
 Abandoned _____

Date 4/24, 1917 Conley Scout

Map No. _____ Sec. 19 Twp. 28 R. 4


Well No. 2 Crabb Farm _____

Salter et al Company _____

NORTH

WEST

EAST

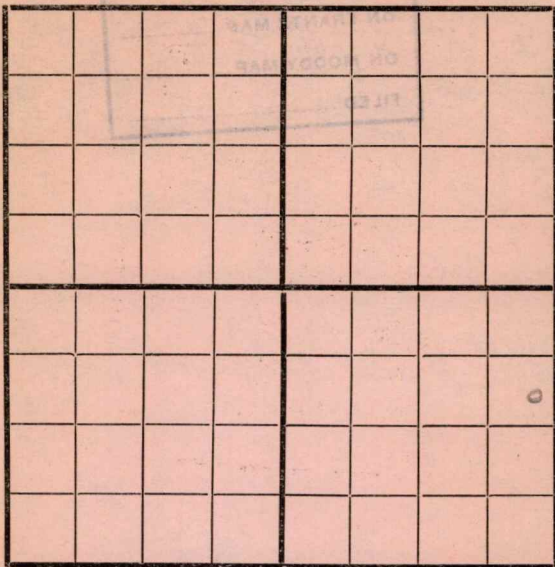

SOUTH

Location _____

Rig Up _____

Drilling and remarks

Spudding

RECORD

Cased _____ in. _____ Ft.

Sand _____

Gas _____

Oil _____

Total Depth _____

PRODUCTION

1st 24 hrs. Nat. _____

1st 24 hrs. after shot _____

Gas _____ Cu. Ft.

• Dry Hole _____

Abandoned _____

Date


5/2, 191 2 Crabb Scout _____

Map No. _____ Sec. 19 Twp. 28 R. 4
 Well No. 2 Crabb Farm _____
Saltwater Company _____

NORTH

WEST

EAST

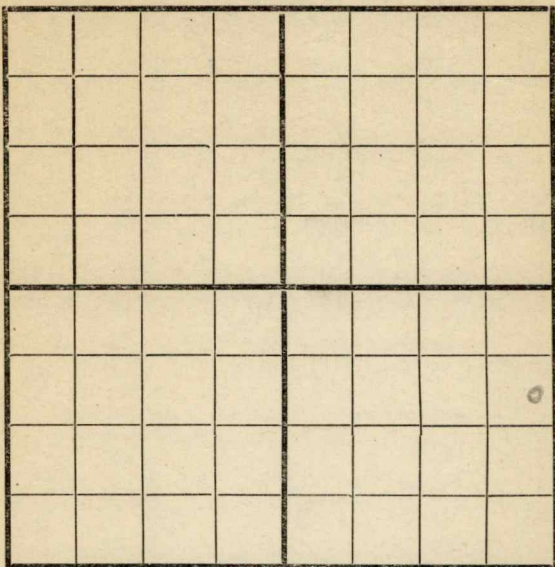

SOUTH

Location _____

Rig Up _____

Drilling and remarks

250

RECORD

Cased _____ in. _____ Ft.

Sand _____

Gas _____

Oil _____

Total Depth _____

PRODUCTION

1st 24 hrs. Nat. _____

1st 24 hrs. after shot _____

Gas _____ Cu. Ft.

Dry Hole _____

Abandoned _____

Date

5/8, 1912 Crabb Scout

Map No. _____ Sec. 19 Twp. 28 R. 4
 Well No. 2 Crook Farm _____
Salter et al Company _____

NORTH

WEST

EAST

SOUTH

Location _____

Rig Up _____

Drilling and remarks

RECORD

Cased _____ in. _____ Ft.

Sand _____

Gas _____

Oil _____

Total Depth _____

PRODUCTION

1st 24 hrs. Nat. _____

1st 24 hrs. after shot _____

Gas _____ Cu. Ft.

Dry Hole _____

Abandoned _____

Date


5/25 191 7 Crook Scout

Map No. _____ Sec. 19 Twp. 28 R. 4
Well No. 2 _____ Farm _____
Salter et al _____ Company _____

NORTH

WEST

EAST

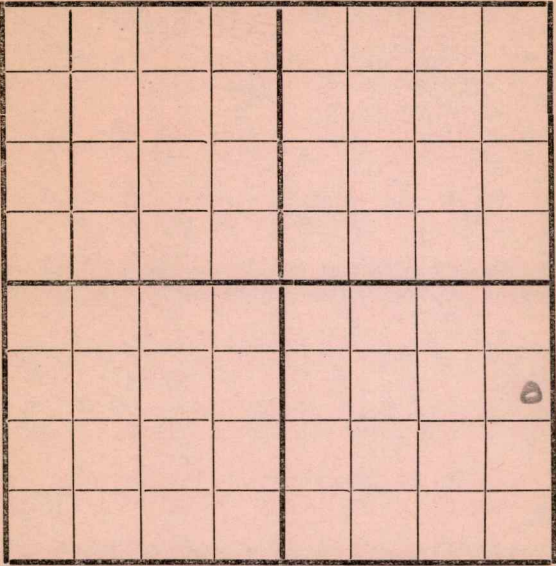

SOUTH

Location _____
Rig Up _____
Drilling and remarks _____

1500'

RECORD

Cased _____ in. _____ Ft.
Sand _____
Gas _____
Oil _____
Total Depth _____

PRODUCTION

1st 24 hrs. Nat. _____
1st 24 hrs. after shot _____
Gas _____ Cu. Ft.
Dry Hole _____
Abandoned _____


Date 5/28, 1912 Carley Scout

Map No. _____ Sec. 19 Twp. 28 R. 4
 Well No. 2300 Farm _____
 _____ Company

NORTH

WEST

EAST

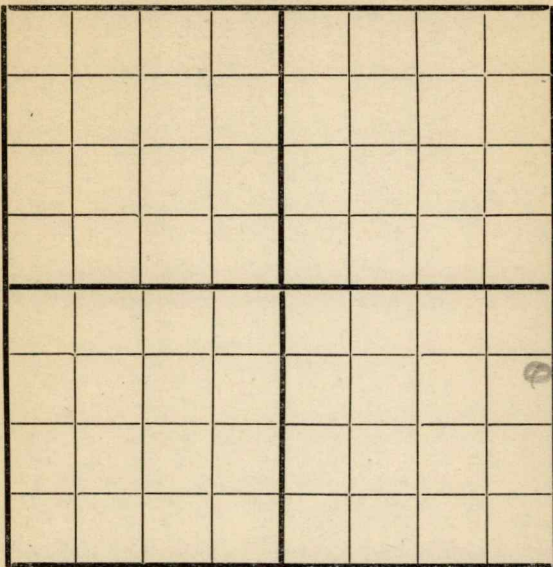

SOUTH

Location _____

Rig Up _____

Drilling and remarks

2300

RECORD

Cased _____ in. _____ Ft.

Sand _____

Gas _____

Oil _____

Total Depth _____

PRODUCTION

1st 24 hrs. Nat. _____

1st 24 hrs. after shot _____

Gas _____ Cu. Ft.

Dry Hole _____

Abandoned _____

Date


6/8, 1917 Andy Scout

Map No. _____ Sec. 19 Twp. 28 R. 4
 Well No. 2 Crabb Farm _____
Saltwater Company _____

NORTH

WEST

EAST

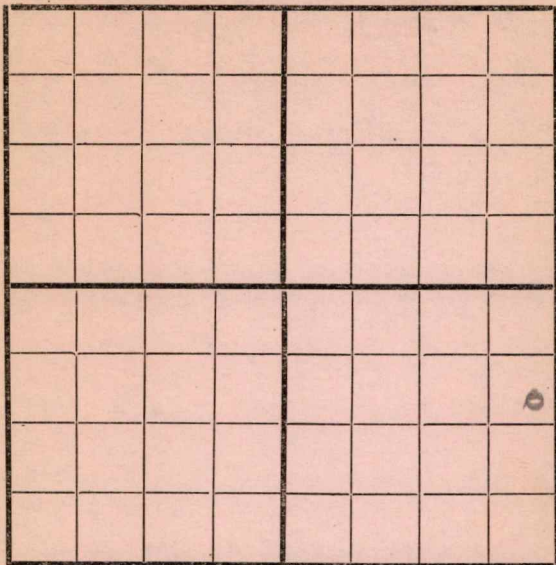

SOUTH

Location _____

Rig Up _____

Drilling and remarks

RECORD

Cased _____ in. _____ Ft.

Sand _____

Gas _____

Oil _____

Total Depth _____

PRODUCTION

1st 24 hrs. Nat. _____

1st 24 hrs. after shot _____

Gas _____ Cu. Ft.

Dry Hole _____


Abandoned _____

Date

191

Scout


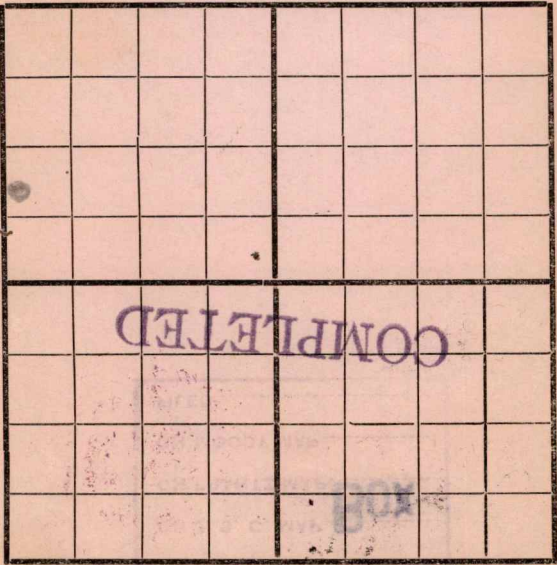

SOUTH

NORTH

EAST

WEST

RECORD

Cased in. Ft. Sand 2464-2487 Gas Total Depth

Oil

PRODUCTION

1st 24 hrs. Nat. 1st 24 hrs. after shot Cu. Ft. Dry Hole Abandoned

Location Rig Up Drilling and remarks

Est at 1001362


7/10/17

Date MAR 24 1917 191 Scout

Carly

Map No. _____ Sec. 19 Twp. 28 R. 4
 Well No. 2000 Farm _____
Sutton et al Company _____

NORTH

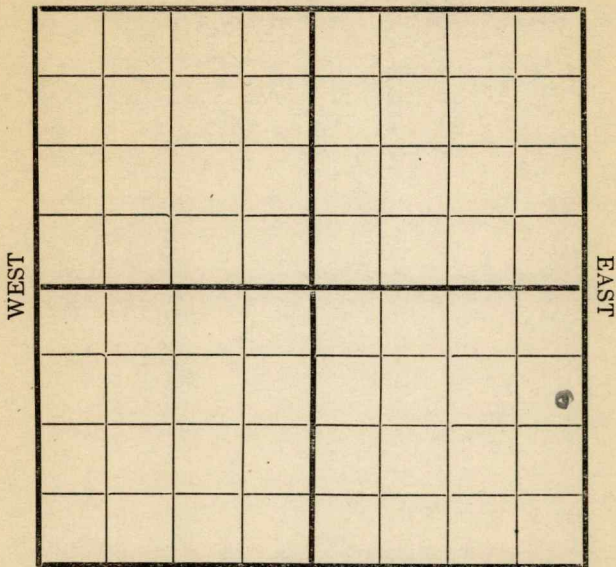

SOUTH

Location _____
 Rig Up _____
 Drilling and remarks _____

Shut Down
1810

RECORD

Cased _____ in. _____ Ft.
 Sand _____
 Gas _____
 Oil _____
 Total Depth _____

PRODUCTION

1st 24 hrs. Nat. _____
 1st 24 hrs. after shot _____
 Gas _____ Cu. Ft.
 Dry Hole _____
 Abandoned _____


Date 6/12, 1917 C. C. Cady Scout

Map No. _____ Sec. 19 Twp. 28 R. 4
 Well No. 3 Crabbe Farm _____
Saltwater Company _____

NORTH

WEST

EAST

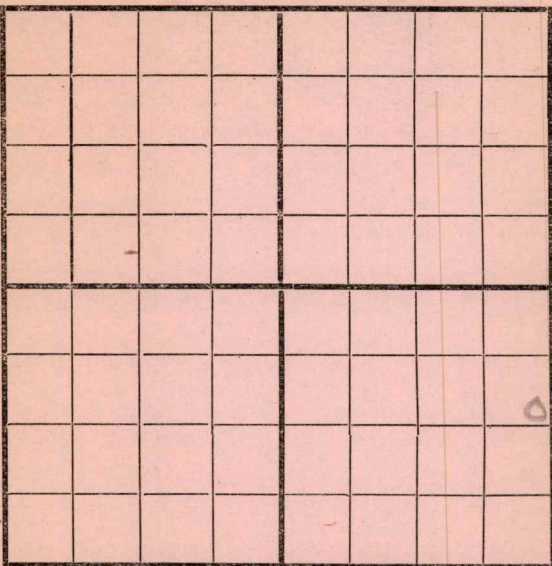

SOUTH

Location _____
 Rig Up _____
 Drilling and remarks _____


RECORD
 Cased _____ in. _____ Ft.
 Sand _____
 Gas _____
 Oil _____
 Total Depth _____

PRODUCTION
 1st 24 hrs. Nat. _____
 1st 24 hrs. after shot _____
 Gas _____ Cu. Ft.
 Dry Hole _____
 Abandoned _____

Date 6/20, 1917 Carley Scout

Map No. _____ Sec. 19 Twp. 28 R. 4
 Well No. 2 Crisp Farm _____
Salter et al Company _____

NORTH

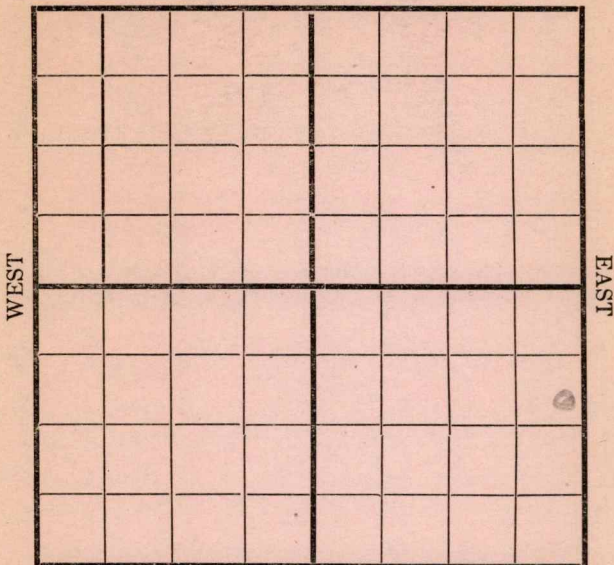

SOUTH

Location _____
 Rig Up _____
 Drilling and remarks _____

2200

RECORD

Cased _____ in. _____ Ft.
 Sand _____
 Gas _____
 Oil _____
 Total Depth _____

PRODUCTION

1st 24 hrs. Nat. _____
 1st 24 hrs. after shot _____
 Gas _____ Cu. Ft.
 Dry Hole _____
 Abandoned _____

Date 6/20 191 7 Landry Scout


Map No. _____ Sec. 19 Twp. 38 R. 4

Well No. 2000 Farm _____

Salter et al Company _____

NORTH

WEST

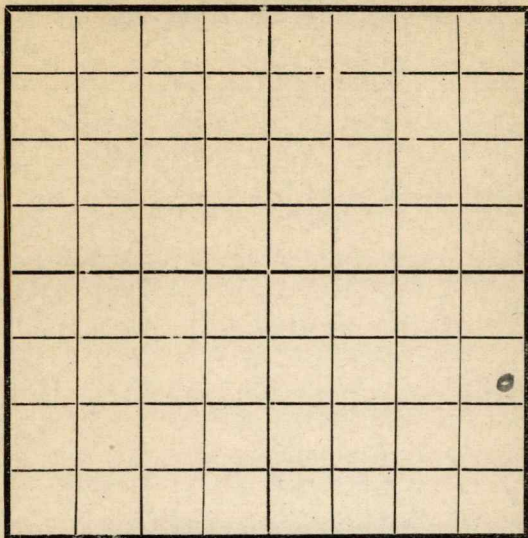

EAST

SOUTH

RECORD

Location _____

Cased _____ in. _____ Ft.

Rig Up _____

Sand _____

Drilling and remarks

Gas _____

Oil _____

Total Depth _____

PRODUCTION

1st 24 hrs. Nat. _____

1st 24 hrs. after shot _____

Gas _____ Cu. Ft.

Dry Hole _____

Abandoned _____

Date


7/6, 1917 Cand Scout

*Horse Crooked
hole at
2300'*

Map No. _____ Sec. 19 Twp. 28 R. 4Well No. 20000 Farm _____
Salter et al Company

NORTH

WEST

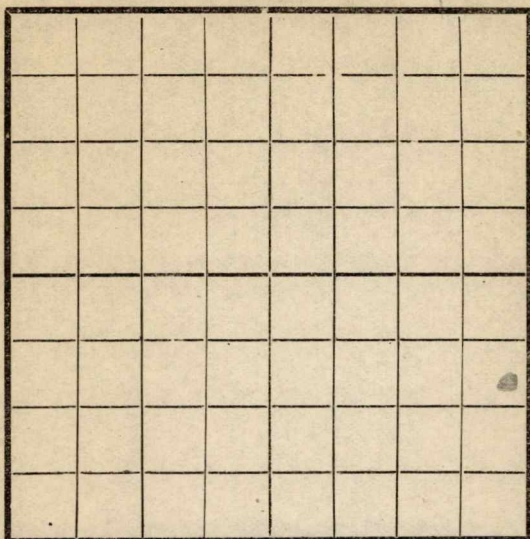

EAST

SOUTH

Location _____

Rig Up _____

Drilling and remarks

2420

RECORD

Cased _____ in. _____ Ft.

Sand _____

Gas _____

Oil _____

Total Depth _____

PRODUCTION

1st 24 hrs. Nat. _____

1st 24 hrs. after shot _____

Gas _____ Cu. Ft.

Dry Hole _____

Abandoned _____

Date

7/12, 1912 20000 Scout