


Section 27 Township 15 Range 14-W

Well No. #2 Karst

Company Derby

Trapp Pool

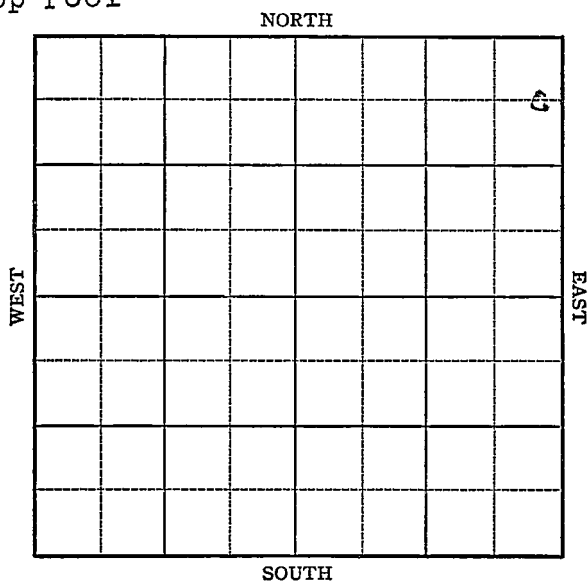

KANSAS

Russell

Sec. 27 Twp. 15 R. 14-W

Well No. #2 Karst Farm

Derby

Company

(Trapp Pool)


660 Ft. from N. Line

Ft. from S. Line

330 Ft. from E. Line

Ft. from W. Line

Elev. 1906

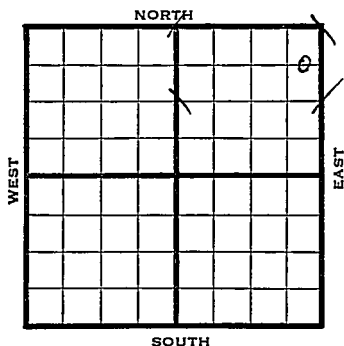

1942

REPORT

9/9

Location

9/16

"

9/23

7" 625' Anhy 906'

Lansing 3105' Drilling 3185'

9/30

TD 3355

Arb. 3350

Treat 1000 acid, swab 4 boph on 4 hrs test.

10/7

Arb. 3350

4" - 3351

2000 acid

Pump 46 Pot.

T.D. 3357

Gravity 39.

COMPLETED

KANSAS

Russell

Map No. 73 Sec. 27 Twp. 15 R. 14WWell No. 2 KarstDerby

Company

FIRST REPORT

Contractor

C E L N E N E

660

Ft. from N. Line


Ft. from S. Line

330

Ft. from E. Line

Ft. from W. Line

SECTION PLAT

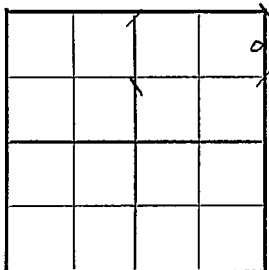

TRAPP POOL

Location XXX

Rig up

Drilling and Remarks:

RECORD

Cased _____ in., _____ ft.

Sand _____

Gas _____

Oil _____

Total Depth _____

PRODUCTION

1st 24 hrs. Nat. _____

1st 24 hrs. after shot _____

Gas _____ Cu. Ft.

Dry Hole _____

Abandoned _____

Date

SEP 9 1942

19

S. J. LEWIS

Scout

Map No. 73 Sec. 27 Twp. 15 R. 14WWell No. 2 KarstDerby

Company

COMPLETED

Contractor

C EL NE NE

660 Ft. from N. Line

Ft. from S. Line

330 Ft. from E. Line

Ft. from W. Line

SECTION PLAT

			o

TRAPP POOL

Location

Rig up

Drilling and Remarks:

*Art 3350**4" C3351**2000 Acid**Pump 46 P.O.**39° E*

RECORD

Cased _____ in., _____ ft.

Sand _____

Gas _____

Oil _____

Total Depth 3357

PRODUCTION

1st 24 hrs. Nat. _____

1st 24 hrs. after shot _____

Gas _____ Cu. Ft.

Dry Hole _____

Abandoned _____

Date

OCT 7 1942

19

S. J. LEWIS Scout