

KANSAS


Rush

FORM 51 5M, PETROL

Section 26 Township 18 Range 16W

Well No. # 3-2 Deighton

Company Harbar Drlg. etal

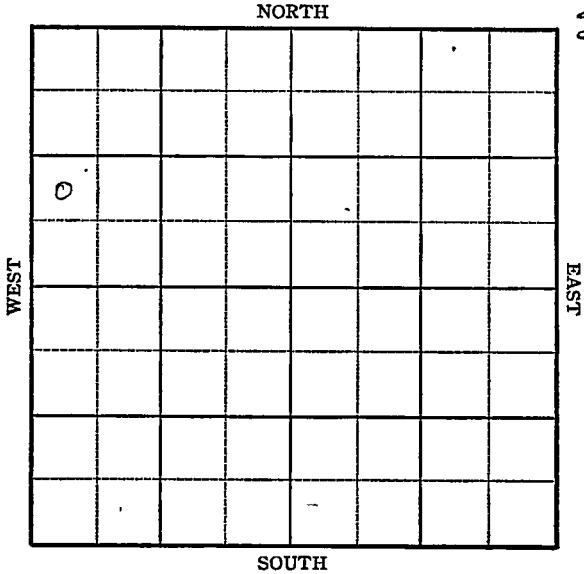


Sec. 26 Twp. 18 R. 16-W

Well No. #3 Deighton Farm

Harbar Drlg. etal Company

 Ft. from N. Line
990 Ft. from S. Line
 Ft. from E. Line
330 Ft. from W. Line

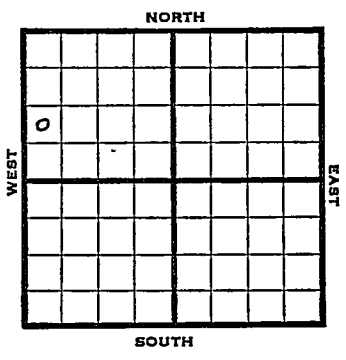

NW SW NW

1945	Elev. 1973' REPORT
11/21	Location
11/28	"
12/5	Derrick
12/12	Surface Hole
12/20	Anhy 1013' 10" - 1025' WOC.
12/29	Drlg. 2530'
1946 1/10	Reagan 3547' 7" - 3547' T.D. 3563' SO. RUST.
1/17	" " "
1/24	TD 3573' SO. Shot 40 qts. C. O. .
1/31	Swab 25 oil per day.
2/7	" " "
2/13	Reagan 3547 7" @ 3547 . 40 qts. TD 3573' Pump 40 Pot. Grav. 35.0

COMPLETED

KANSASKansas Pool Name AlbertMap No. 74 Sec. 26 Twp. 18 R. 16WWell No. 2 DeightonHarbar Drlg. etal. Company**FIRST REPORT**

Contractor

NW SW NW

SECTION PLAT

◊			

 Ft. from N. Line990 Ft. from S. Line Ft. from E. Line330 Ft. from W. LineRush CountyLocation XRig up

Drilling and Remarks:

RECORDCased in., ft.Sand Gas Oil Total Depth **PRODUCTION**1st 24 hrs. Nat. 1st 24 hrs. after shot Gas Cu. Ft.Dry Hole Abandoned

Date

NOV 21 1945 19S. J. LEWIS Scout

KANSAS Kansas Pool Name AlbertMap No. K-74 Sec. 26 Twp. 18 R. 16WWell No. 3 DeightonHarbar Drlr. etal

Company

CORRECTION

Contractor

1/4 SW NW

SECTION PLAT

o			

_____ Ft. from N. Line

990 _____ Ft. from S. Line

_____ Ft. from E. Line

330 _____ Ft. from W. LineRush County

Location _____

Rig up _____

Drilling and Remarks:
reported as #2
Deighton

RECORD

Cased _____ in., _____ ft.

Sand _____

Gas _____

Oil _____

Total Depth _____

PRODUCTION

1st 24 hrs. Nat. _____

1st 24 hrs. after shot _____

Gas _____ Cu. Ft.

Dry Hole _____

Abandoned _____

Date

DEC 12 1945

19

S. J. LEWIS

Scout

KANSAS Pool Name Albert Pool
 Map No. 7C Sec. 26 Twp. 18 R. 16W
 Well No. 3 Deighton

Harbar Drlg. etal Company

COMPLETED

Contractor

NW SW NW

E. 1923

SECTION PLAT

_____ Ft. from N. Line

990 Ft. from S. Line

_____ Ft. from E. Line

330 Ft. from W. Line

0			

Rush County

Location _____

Rig up _____

Drilling and Remarks:

Reagan 3047
7' @ 3047
40 ft.
Pump 40 RT

302-31

RECORD

Cased _____ in., _____ ft.

Sand _____

Gas _____

Oil _____

Total Depth 3523

PRODUCTION

1st 24 hrs. Nat. _____

1st 24 hrs. after shot _____

Gas _____ Cu. Ft.

Dry Hole _____

Abandoned _____

Date

FEB 13 1946