


Section 26 Township 18 Range 16-W

Well No. 1 - Hergert

Company Carter

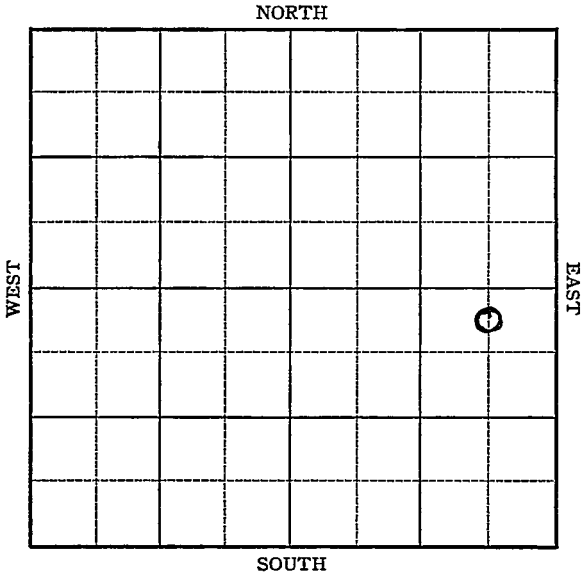

Sec. 26 Twp. 18 R. 16


Well No. #1 Hergert Farm
Carter Company

330 Ft. from N. Line

_____ Ft. from S. Line

660 Ft. from E. Line

_____ Ft. from W. Line

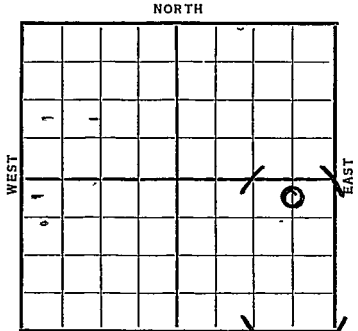

SPECIAL

Date	Elev. 1943	REPORT
1937		
6/9	Mov. in Mat.	
6/19	R. R.	
6/25	"	
7/2	"	
7/9	Drlg. 250'	
7/16	15" @ 250'. Anhy 956'.	
	10" @ 979'. Drlg. 1975'.	
7/23	Drlg. 2535'.	
7/30	Drlg. 2855'.	
8/6	K.C. 3350'. Drlg. 3510'.	
8/14	Top Regan 3519'. 7" at 3520'.	
	1st gas 3537'. Oil Pay 3550-53'.	
	T.D. 3553'. H.F. oil in 45 Min.	
	Well has enough gas to flow it.	
	Testing. (Tel)	
8/16	Estimate 100 bbls. per hour well	
	Building tanks (Tel)	
	OVER	OVER

Running 23 feet higher than Schermerhorn #1
Moore NW/c 25-18-16 which was completed for
108 bbls.

Running 18 feet higher than Morgan & Flynn
#2 Gisick SE/c 25-18-16W which was completed
for 88 bbls.

Top Regan 3519-53

8/19--Flowed 91 bbls. 1st hour

" 70 " 2nd "

" 62 " 3rd "

Still flowing Just enough gas to flow
well No estimate on gas (Tel)

8/20--Potential 1428 bbls. flowing

Estimate 1 to 2 M Gas (Telegram)

8/25 7" @ 3520'

Regan 3519'

Oil pay 3550-53'

TD 3553'

Flowed 286/4
238/4

Pot 1428

Grav. 34

COMPLETED

WONGAS *Rush*

Map No. 74 Sec. 26 Twp. 18 R. 16 W

Well No. 1-Hergert

Carter Company

Contractor

FIRST REPORT

SECTION PLAT

			0

330 Ft. from N. Line

 Ft. from S. Line

660 Ft. from E. Line

 Ft. from W. Line

Special

Location _____

Rig up _____

Drilling and Remarks:

mov. in mat

RECORD

Cased _____ in., _____ ft.

Sand _____

Gas _____

Oil _____

Total Depth _____

PRODUCTION

1st 24 hrs. Nat. _____

1st 24 hrs. after shot _____

Gas _____ Cu. Ft.

Dry Hole _____

Abandoned _____

Date

JUN 9 1937

H. D. Hatfield Scout

Rush KANSAS

Map No. _____ Sec. 26 Twp. 18 R. 16 WWell No. 1 - HergertCarter Company_____
Contractor

COMPLETED

SECTION PLAT

330 Ft. from N. Line

_____ Ft. from S. Line

660 Ft. from E. Line

_____ Ft. from W. Line

			0

Location _____

Rig up _____

Drilling and Remarks:

oil pay 3550-53

flowed 28 3/4

238 3/4

Pot. 1428
gravel 34

RECORD

Cased 7 in. 3520 ft.Sand Regan 3519

Gas _____

Oil _____

Total Depth 3553

PRODUCTION

1st 24 hrs. Nat. _____

1st 24 hrs. after shot _____

Gas _____ Cu. Ft.

Dry Hole _____

Abandoned _____

Date

AUG 25 1937

19

H. D. Hatfield Scout