

Rush

KANSAS

26

18S

16W

SECTION \_\_\_\_\_ TOWNSHIP \_\_\_\_\_ RANGE \_\_\_\_\_

#1 Hergert

WELL NO. \_\_\_\_\_


Stickle Drlg. Co.

COMPANY \_\_\_\_\_

NORTH

N/2 N/2 SE

9

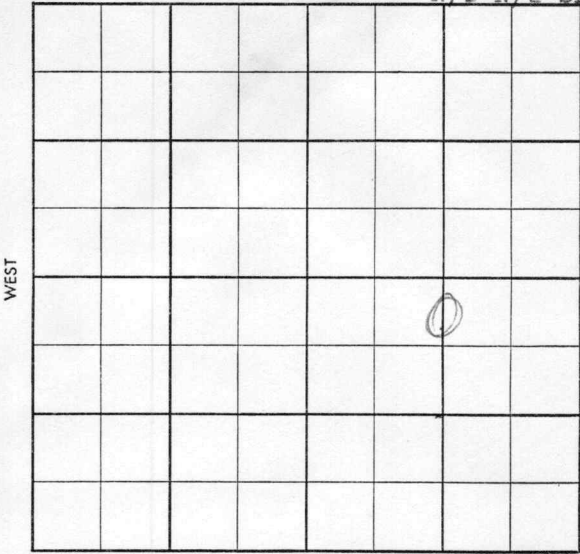

SOUTH

✓  
14

County Rush Elev. \_\_\_\_\_  
 Sec. 26 Twp. 18 Rge. 16W  
 Company Stickle Drlg. Co.  
 Farm Name Hergert No. 1

TOPS	DEPTH	LOG	DATUM
Anh.			
Tp.			
H.			
Tr.			
Dg.			
B.L.			
L.			
K.C.			
B.K.C.			
Ce.			
C.			
M.			
M.			
K.			
Mz.			
Mq.			
V.			
S.			
S.			
A.			
R.			
Pf.			
G.			
T.D.			

Loc. in Sec. N/2 N/2 SE  
 Geol. \_\_\_\_\_  
 Contr. \_\_\_\_\_  
 Co. Tools Co. Tools  
 Pool Otis-Albert



Date Comm. 2/5/58  
8" @ 976 Drlg. 3140

Co.  
Lse.  
No.  
Sec.  
T.  
R.

Top N Pool N  
 Co. X Foss N

5-513-B

County Rush Elev. 19370' 1940' 1940'  
 Sec. 26 Twp. 18 Rge. 16W  
 Company Stickle Drlg. Co.  
 Farm Name Hergert No. 1

TOPS	DEPTH	LOG	DATUM	Loc. in Sec.
Anh.				<u>N/2 N/2 SE</u>
Tp.				
H.	<u>3161</u>			
Tr.				
Dg.				
B.L.				
L.				Geol.
K.C.	<u>3232</u>			Contr.
B.K.C.				<u>Co. Tools</u>
Ce.				Pool
C.				<u>Otis-Albert</u>
M.				
M.				
K.				
Mz.				
Mq.				
V.				
S.				
S.				<b>COMPLETE</b>
A.				
R.	<u>3515</u>			
Pf.				
G.	<u>3552</u>			<u>MAR 19 1958</u>
T.D.	<u>3564</u>			

Date Comm. 2/5/58  
 8" @ 976 Drlg. 3140 FEB 19 '58 5" 3563. WOC  
 FEB 26 '58 MAR 5 '58 12/3543 1/2 - 46 1/2 FU  
1900 oil 4 hrs NAT pop MAR 12 '58 9/0  
6P 30 B FPD 40% W MAR 19 '58 P15  
130nd + 50' down