

Section 27 Township 15 Range 14WWell No. #5 KarstCompany Derby Oil

						0	

NORTH

WEST

EAST

SOUTH

Russell KANSAS

15

14W



Sec. 27 Twp. R.

Well No. #5 Karst Farm

Derby Oil Company

Peel Drlg. Contractor

Trapp Pool


330' Ft. from N. Line

Ft. from S. Line

990' Ft. from E. Line

Ft. from W. Line

NW NE NE

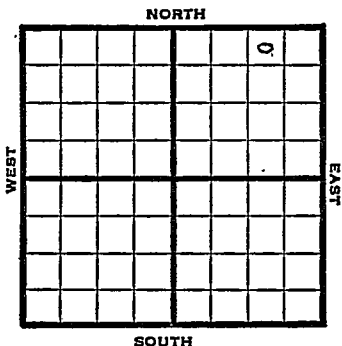

1950

Elev. 1896' REPORT

9/27

Spud 9-25-50

Drlg. 570'

11/1

Spud 9-25-50

Oil Well TD 3347

8" @ 569' Heeb 3034'

Lans. 3098' Arb. 3344-46'

4 1/2" @ 3345'

TD 3347 S/3 1/4 BOPH 500 A

S/7 BOPH 9 hr. Comp. 45 BOPD

COMPLETED

County Russell State Kans.Sec. 27 (Blk.) 15 (Sur.) 14W Map No.Operator Derby OilWell No. 5 Farm KarstElev. Location NW NE NE

						0

330 Ft. From N Line NE990 Ft. From E Line Quarter1st. Report SEP 27 1950

Completion

Remarks

Peel Drlg. - Contr.Spudding Date 9-25-50Drlg. Data Trapp Pooldrlg. 570

J. E. TYRA

County Russell State Kansas
 Sec. 27 (Blk.
Twp.) 15 (Sur.
Rge.) 14W Map No.
 Operator Derby Oil.
 Well No. 5 Farm Karst
 Elev. 1896 Location NW NE NE

330 Ft. From N Line NE
 990 Ft. From E Line Quarter

1st. Report

Completion NOV 1 1950

Remarks Trapp Pool
Peel Drlg. - Contr.

Spudding Date 9-25-50

Drlg. Data Oil well TD 3347

8" @ 569 Heeb. 3034 Lans. 3098

Arh. 3344-46 4 $\frac{1}{2}$ " @ 3345 TD 3347

S/ 3 $\frac{1}{2}$ boph 500 A S/ 7 boph 9 hr.

Comp. 45 bopd

J. E. TYRA