KANSAS

FORM 51 5M BRIX


Rush County

Section 26 Township 18 Range 16W

Well No. #2 Hergert

Company Nadel & Gussman et al

Albert

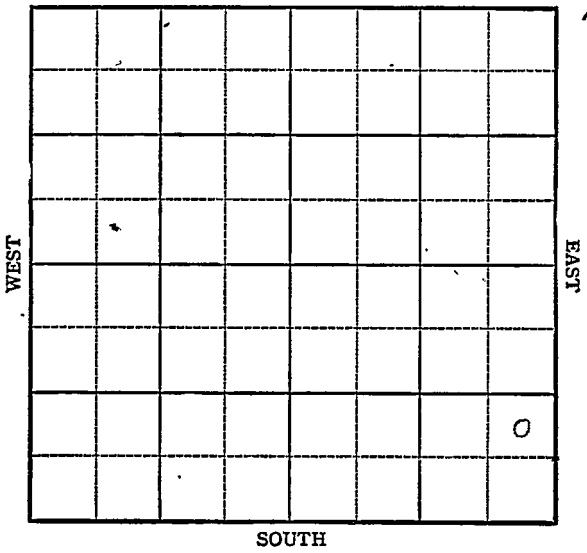

FORM 252-A
5M 9-44 PETROL


KANSAS — Rush County

Sec. 26 Twp. 18 R. 16W

Well No. #2 Hergert Farm

Nadel & Gussman et al Company

Albert

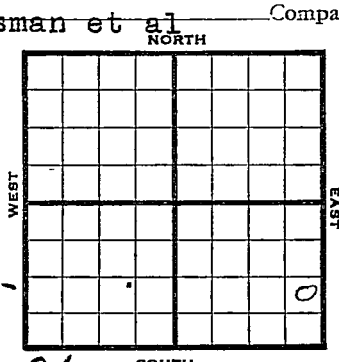

____ Ft. from N. Line

990 Ft. from S. Line

330 Ft. from E. Line

____ Ft. from W. Line

NE SE SE Elev. 1961

1944	REPORT
10/25	MIR
11/2	Drlg. 975
11/8	Anhy 989 8" @ 989 Drlg. 2548
11/16	Cong 3537 Basel Sd 3560-3561 TD 3561 5" @ 3560 RUST
11/24	T D 3565 S O
11/29	TD 3567 swb 1 oil per hr.
12/6	" " " " " " "
12/14	" " " " " " "
12/21	" " " " " " "
12/29	" " " " " " "
1945	
1/10	Basal sd 3560 5" @ 3560 TD 3567 Pump 25 Pot Grav. 35.0

COMPLETED

FORM 56 200 BKS. 1-44 PETROL

Pool Name Albert

Map No. KANSAS 1 Sec. 26 Twp. 18 R. 16W


Well No. 2 Herger t

Nadel & Gussman etal Company

FIRST REPORT Contractor

NE SE SE

SECTION PLAT

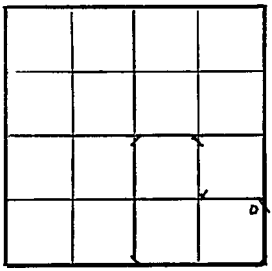

____ Ft. from N. Line

990 Ft. from S. Line

330 Ft. from E. Line

____ Ft. from W. Line

Rush

Location

Rig up

Drilling and Remarks:

M I R

RECORD

Cased ____ in., ____ ft.

Sand

Gas

Oil

Total Depth

PRODUCTION

1st 24 hrs. Nat.

1st 24 hrs. after shot

Gas ____ Cu. Ft.

Dry Hole

Abandoned

Date

OCT 25 1944 19 S. J. LEWIS Scout

FORM 26 200 BKS 1 44 PETROL

Pool Name Albert

Map No. 74 Sec. 26 Twp. 18 R. 16W

Well No. 2 Hergert


Nadel & Gussman etal Company

COMPLETED

Contractor

NE SE SE

SECTION PLAT

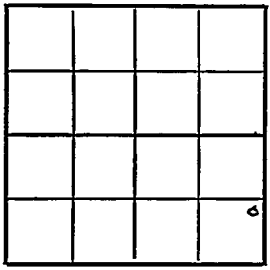

Ft. from N. Line

990 Ft. from S. Line

330 Ft. from E. Line

Ft. from W. Line

Rush

Location

Rig up

Drilling and Remarks:

Base L Sd 3560

5" @ 3560

Perf 2 SPF

35-2 Gr

RECORD

Cased in., ft.

Sand

Gas

Oil

Total Depth 3567

PRODUCTION

1st 24 hrs. Nat.

1st 24 hrs. after shot

Gas Cu. Ft.

Dry Hole

Abandoned

Date

JAN 10 1945 19

S. J. LEWIS Scout