

KANSAS


Rush

FORM 51 5M PETROL

Section 26 Township 18 Range 16W

Well No. 3 Hergert

Company Nadel & Gussman

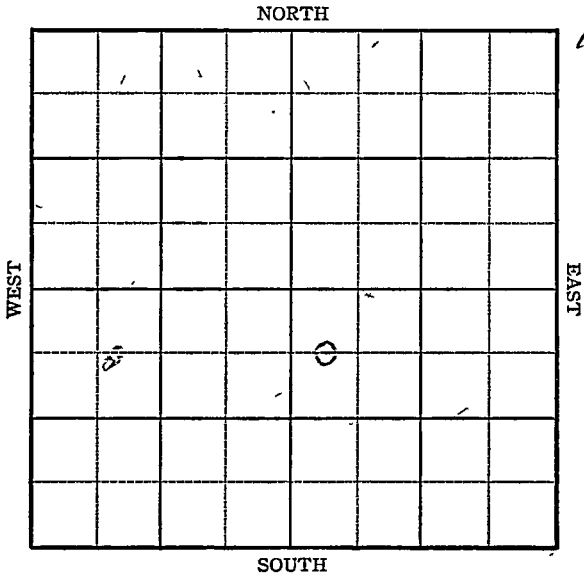

Sec. 26 Twp. 18 R. 16-W

Well No. #3 Hergert Farm


Nadel & Gussman Company

660 Ft. from N. Line

_____ Ft. from S. Line

_____ Ft. from E. Line

330 Ft. from W. Line

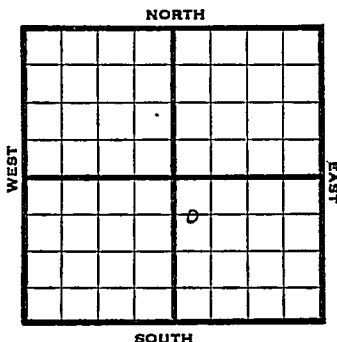

C W L NW SE

1945 Elev. 1938 REPORT

9/19	RUR			
9/26	Anhy. '965			
	8" @ 965			
	Drig. 1975			
10/3	Drig. 3530"			
10/10	Reagan 3544			
	TD 3558 S Gas			
	5" @ 3544 RUST			
10/17	Flow 95 oil in 12 hrs.			
10/24	" " " "			
10/31	" " " "			
11/7	" " " "			
11/14	" " " "			
11/21	" " " "			
11/28	" " " "			
12/5	" " " "			
12/12	Reagan 3544			
	5" @ 3544			
	TD 3558			
	Pump 100 Pot.			
	Grav. 36.0			

COMPLETED

KANSAS

Well Name AlbertMap No. 74 Sec. 26 Twp. 18 R. 16WWell No. 3 HergetNadel & Gussman Company

FIRST REPORT

Contractor

C W L NW SE

SECTION PLAT

660 Ft. from N. Line

_____ Ft. from S. Line

_____ Ft. from E. Line

330 Ft. from W. Line

		2	

Rush County

RECORD

Location _____

Cased _____ in., _____ ft.

Rig up _____

Sand _____

Drilling and Remarks:

Gas _____

RUR

Oil _____

Total Depth _____

PRODUCTION

1st 24 hrs. Nat. _____

1st 24 hrs. after shot _____

Gas _____ Cu. Ft.

Dry Hole _____

Abandoned _____

Date

SEP 1 9 1945 19S. J. LEWIS Scout

KANSAS

Kansas Pool Name Albert

Map No. K-74 Sec. 26 Twp. 18 R. 16W

Well No. 3 Hergert

Nadel & Gussman Company

COMPLETED

Contractor

C W L NW SE

E. 1938

SECTION PLAT

660 Ft. from N. Line

_____ Ft. from S. Line

_____ Ft. from E. Line

330 Ft. from W. Line

		a	

Rush County

Location _____

Rig up _____

Drilling and Remarks:

Reagan 3544
5" C 3544
Pump 100 Bx

36 2/3

RECORD

Cased _____ in., _____ ft.

Sand _____

Gas _____

Oil _____

Total Depth 355

PRODUCTION

1st 24 hrs. Nat. _____

1st 24 hrs. after shot _____

Gas _____ Cu. Ft.

Dry Hole _____

Abandoned _____

Date

DEC 12 1945

19

S. J. LEWIS

Scout