
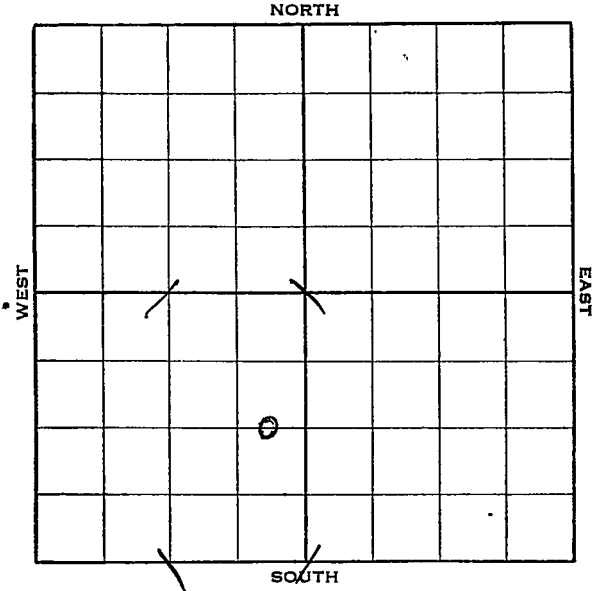


Section 26 Township 18 Range 16-W

Well No. 1 Strong

Company Schermerhorn-Winton et al

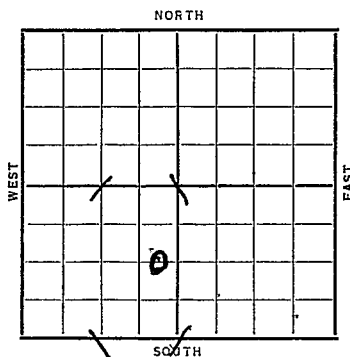

Sec. 26 Twp. 18 R. 16-WWell No. #1 Strong FarmSchermerhorn-Winton et al Company Ft. from N. Line1320 Ft. from S. Line330 Ft. from E. Line Ft. from W. Line**Special**

Date	Elev. 1944	REPORT
1938		
3/16	R. R.	
3/25	16" @ 160'.	WOC.
4/1	10" @ 978'.	Drl g. 1486'.
4/8	Anhy 978'.	Topeka 2829'.
		Drl g. 3125'.
4/12	Cored 3525-37--recovered 6 feet conglomerate No top determined yet Coring at 3547 (Tel) .	
4/12	Top Conglomerate 3512 Reagan Sand 3552 show oil Rust (Teleg) Running ³ / ₃₂ feet lower on top Reagan than Carter #1 Hergert located in CNL NE SE 26-18-16W completed for 1428 bbls. Running ² / ₄ feet lower on Reagan sand than Carter #1 Pascoe in CNL NW NW 36-18-16W, completed for 150 bbls.	
		OVER

1938

4/15 K. C. 3278'. Cong. 3514'.
Reagan sand ~~3552'~~ 3550
T.D. 3552'. S.O. 7" @ ~~3552'~~ 3546.
RUST.

4/19--Drilled plugs No show
Waiting on Schermerhorn officials to
arrive before starting up (Tel)

4/19--Top Sand 3550 (Corrected) 7" 3546
T.D. now 3561
Filled up 200 feet oil in 50 minutes
Estimated 1 M Gas
Swabbed 5 bbls. oil per hour
No estimate number hours swabbed
Gravity 38 at 95 (Tel)

Running 30' lower on Reagan sand than Carter
#1 Hergert CNL NE SE 26-18-16W completed for
1428 bbls.

Running 2' lower on Reagan sand than Carter
#1 Pascoe CNL NW NW 36-18-16W completed for
150 bbls.

4/21--At T.D. 3561 swab 35 bbls. oil in 9 hrs.
Deepened to T.D. 3581
Filled up 1000 feet oil in 12 hrs.
Swabbed 50 bbls. oil in $7\frac{1}{2}$ hours
Will shoot (Tel)

4/29 T.D. 3580'.
Shot 20 qts. 3553-59'.
Swab 10 oil & 2 wtr. per hour.
P.B. to 3575'.

5/3--P.B. to 3575 Potential
1st 4 hrs. pump 71 bbls. oil
2nd 4 " " 48 " "
Potential 293 bbls. No water (Tel)

OVER



1938

5/4 7" @ 3546'.
Reagan 3550'.
T.D. 3580'.
P.B. 3573'.
Potential 293 bbls.
No water.

COMPLETED

22

Map No. 74 Sec. 26 Twp. 18 R. 16WWell No. 1 StrongSchermerhorn-Winton et al Company

Contractor

COMPLETEDC E L SW

_____ Ft. from N. Line

1320 Ft. from S. Line330 Ft. from E. Line

_____ Ft. from W. Line

SECTION PLAT

		0	

Location _____

Rig up _____

Drilling and Remarks:

P.B. 3573POT 293
NO WTR**RECORD**Cased 7 in., 3546 ft.Sand Reagan 3550

Gas _____

Oil _____

Total Depth 3580**PRODUCTION**

1st 24 hrs. Nat. _____

1st 24 hrs. after shot _____

Gas _____ Cu. Ft.

Dry Hole _____

Abandoned _____

Date

MAY 4 - 1938

19

H. D. Hatfield Scout