

Section 27 Township 15 Range 11 WWell No. # 1 StreckerCompany Murphin & Weaver

NORTH

WEST								EAST
			0					

SOUTH

Russell

KANSAS

Sec. 27 Twp. 15 R. 14W

Well No. #1 Strecker Farm

Murphin & Weaver Company

Contractor


Ft. from N. Line

330' Ft. from S. Line

330' Ft. from E. Line

Ft. from W. Line

SE SE SW

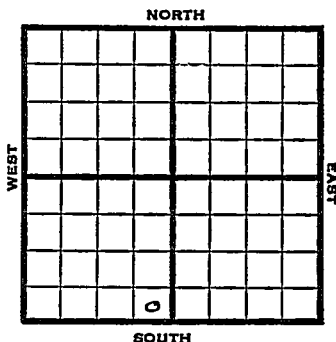

1951 Elev. 1888' REPORT

7/3 Location
7/18 Spud 7-3-51
D & A TD 3381' 8" @ 141
Anhy 902' Top 2837' Heeb 3047'
Lans. 3109' Arb. 3351'
TD 3381' D & A

ABANDONED

County Russell State Kansas

Sec. **27** (Blk.) **15** (Sur.) **14W** Map No.

Operator Murphy & Weaver

Well No. 7 Farm Strecker

Elev.	Location	SE	SE	SW
-------	----------	----	----	----

FIRST REPORT

330 Ft. From S Line SW

350	Ft. From	E	Line	Quarter
-----	----------	---	------	---------

1st. Report **JUL 3 1951**

Completion 2

Remarks

Spudding Date _____

Drlg. Data

Location _____

J. E. TYRA

County Russell State Kansas

Sec. 27 (Blk. Twp.) 15 (Sur. Rge.) 14W Map No.

Operator Murfin & Weaver

Well No. 1 Farm Strecker

Elev.	1888	Location	SE SE SW
-------	------	----------	----------

330 Ft. From S Line SW

330 Ft. From E. Line Quarter

1st. Report

Completion JUL 18 1951

Remarks

Spudding Date 7-3-51

Drig. Data D & A TD 3381

8" @ 141 Anhy 902 Top. 2837

Heeb. 3047 Lans. 3109 Arb. 3351

TD 3381 D & A

J. E. TYRA