

KANSAS


Ellis

FORM 51 5M 1-42 PETROL

Section 17 Township 15 Range 17-W

Well No. #1 Leiker

Company Schermerhorn Oil Corp.

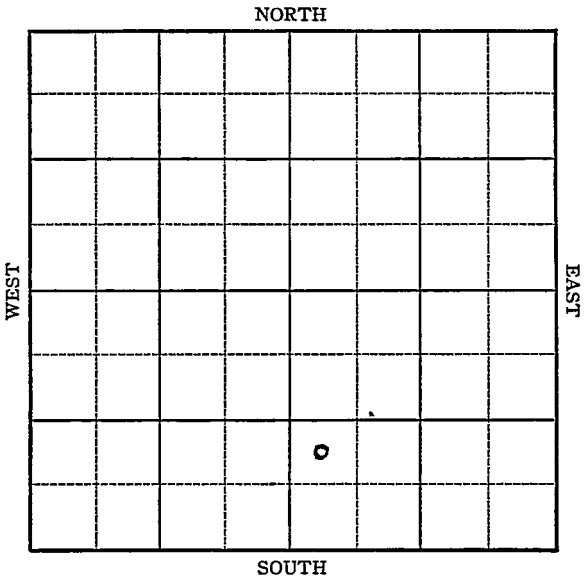

KANSAS

Ellis

Sec. 17 Twp. 15 R. 17-W

Well No. #1 Leiker Farm

Schermerhorn Oil Corp. Company


 Ft. from N. Line

990 Ft. from S. Line

 Ft. from E. Line

330 Ft. from W. Line

Elev 1974

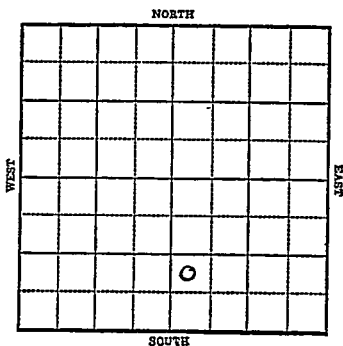

1943

R E P O R T

5/5 270' Run 12".

5/12 12" @ 270'
8" @ 1114'
WOC.

5/19 "

5/26 Arb. 3598
T.D. 3630'
No shows

ABANDONED

KANSAS
Map No. 4 Sec. 17 Twp. 15 R. 17WWell No. 1 LeikerSchermerhorn Oil Corp. Company

FIRST REPORT

Contractor

NW SW SE

SECTION PLAT

		o	

 Ft. from N. Line990 Ft. from S. Line Ft. from E. Line330 Ft. from W. Line

WILD CAT

Location Rig up

Drilling and Remarks:

270' Run 12"

RECORD

Cased in., ft.Sand Gas Oil Total Depth

PRODUCTION

1st 24 hrs. Nat. 1st 24 hrs. after shot Gas Cu. Ft.Dry Hole Abandoned

Date

MAY 5

1943

19

S. J. LEWIS Scout

Ellis


KANSAS

Map No. 74 Sec. 17 Twp. 15 R. 17WWell No. 1 LeikerSchermerhorn Oil Corp. CompanyABANDONED

Contractor

NW SW SE

SECTION PLAT

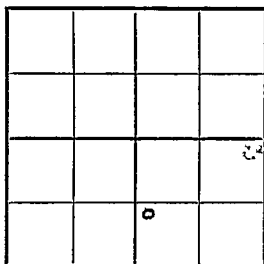 Ft. from N. Line990 Ft. from S. Line Ft. from E. Line330 Ft. from W. Line

WILD CAT

Location Rig up

Drilling and Remarks:

*See 3598**No shows*

RECORD

Cased in., ft.Sand Gas Oil Total Depth 3630

PRODUCTION

1st 24 hrs. Nat. 1st 24 hrs. after shot Gas " Cu. Ft.Dry Hole Abandoned

Date

MAY 26 1943

19

S. J. LEWIS

Scout