


Section 18 Township 15 Range 17W

Well No. #1 Leiker

Company Lindas Oil

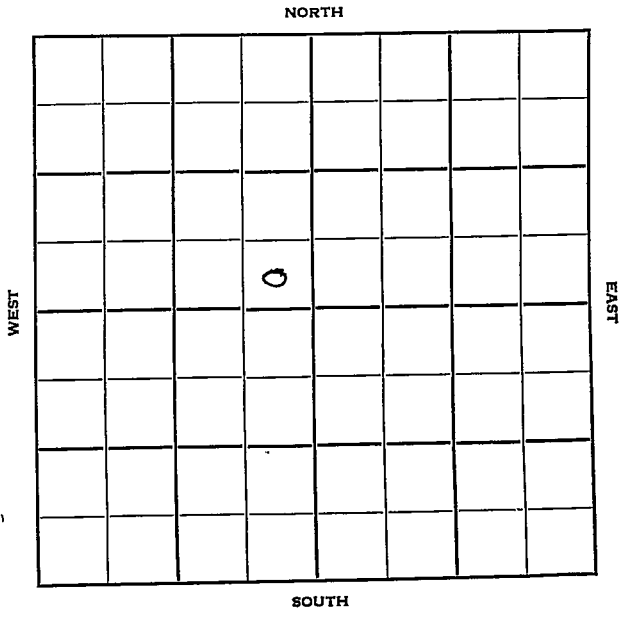

Sec. 18 Twp. 15 R. 17W

Well No. #1 Leiker Farm

Lindas Oil Company

Lindas Contractor

Semi-Wildcat


Ft. from N. Line

330 Ft. from S. Line

330 Ft. from E. Line

Ft. from W. Line

SE SE NW

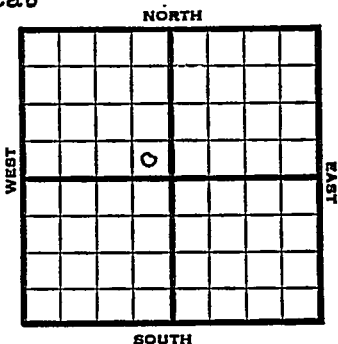

1952 Elev. 1988' REPORT

- 10/8 Spud 10-5-52
Drlg. 800'
- 10/15 Heeb 3229, Lans 3279
Drlg. 3440'
- 10/22 Arb. 3555'
RTD 3558'
Sch
5" @ 3556'
- 10/29 DD 3559' 1 BOPH 500 A S/1½ BOPH
dec. to 1/2 BOPH DD 3560' 100 A
S/5-3/4 BO 4 hrs. DD 3561'
S/7-3/4 BO 3 hrs. DD 3562' TD
S/23-3/4 BO 6 hrs. S/15 BO PB 3557
- 11/5 60' 3562 S/ 2½ Boph for 2 hrs.
1000 A S/ 5 Boph
- 11/12 NR
- 11/20 P/50 BOPD

OVER

1952
11/26

Spud 10-5-52 Oil well TD 3562'
8" @ 1150 Heeb 3229' Lans. 3279'
Arb. 3555' TD 3558' 5" @ 3556
DD 3559 1 BOPH 500 A S/1 $\frac{1}{2}$ BOPH
dec. to $\frac{1}{2}$ BOPH DD 3560 100 A
S/5.84 BO 4 hr. DD 3561 S/7-3/4 BO
3 hr. DD 3562 S/23-3/4 BO 6 hr.
S/15 BO P/B 3557 CO to 3562'
S/2 $\frac{1}{2}$ BOPH 2 hr. 1000 A S/5 BOPH
Comp. 50 BOPD

COMPLETED


County Ellis State Kansas

Sec. 18 (Blk. Twp.) 15 (Sur. Rge.) 17W Map No.

Operator Lindas Oil

Well No. 1 Farm Leiker

Elev. _____ Location SE SE NW

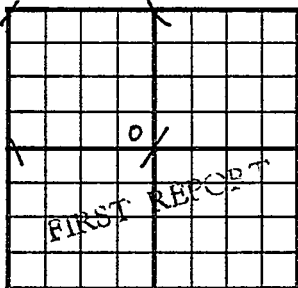

330 Ft. From S Line NW

330 Ft. From E Line Quarter

1st. Report OCT 8 1952

Completion _____

Remarks _____

Lindas - Contr.

Spudding Date 10-5-52

Drlg. Data Semi Wildcat

drlg. 800

J. G. McGEHEE


County Ellis State Kansas

Sec. 18 (Blk. 15 (Sur. 17W Map No. 15)
 (Twp.) (Rge.)

Operator Lindas Oil

Well No. 1 Farm Leiker

Elev. 1988 Location SE SE NW

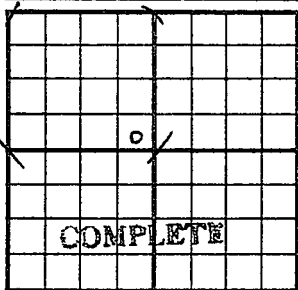

330 Ft. From S Line NW

330 Ft. From E Line Quarter

1st. Report

Completion NOV 26 1952

Remarks Semi Wildcat

Lindas - Contr.

Spudding Date 10-5-52

Drlg. Data Oil well TD 3562

8" @ 1150 Heeb. 3229 Lans. 3279

Arb. 3555 TD 3558 5" @ 3556

DD 3559 1 boph 500 A S/ 1 1/2 boph

dec. to 1/2 boph DD 3560 100 A

S/ 5.84 bo 4 hr. DD 3561 S/ 7 3/4 bo

3 hr. DD 3562 S/ 23 3/4 bo 6 hr.

S/ 15 bo PB 3557 CO to 3562

S/ 2 1/2 boph 2 hr. 1000 A S/ 5 boph

Comp. 50 bopd