

FORM 51


Ellis

KANSAS

Section 19 Township 15 Range 17W

Well No. #1 Dumler

Company Peel - Hardman Oil Producing

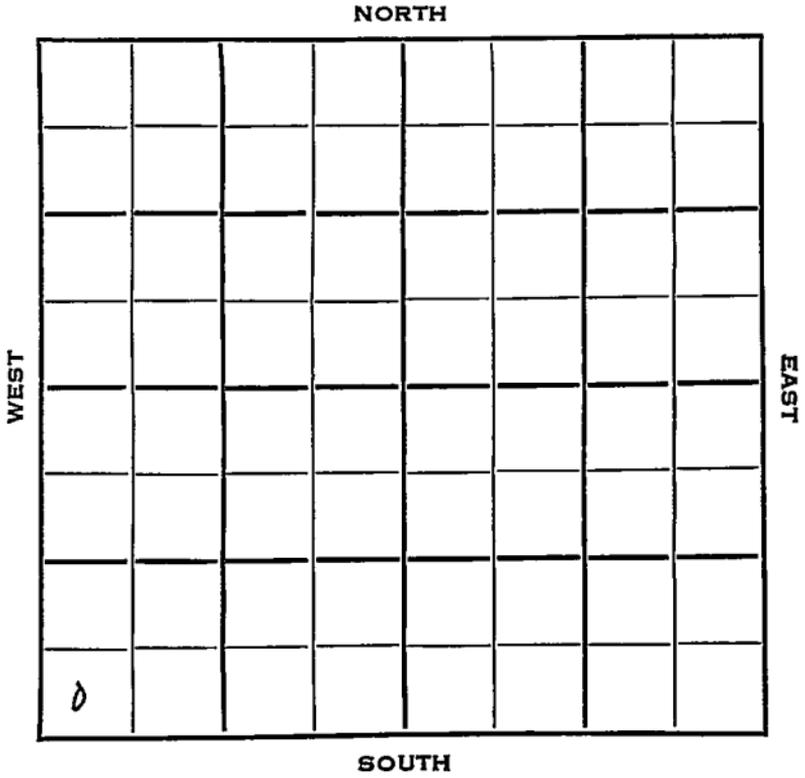



Sec. 19 Twp. 15 R. 17 W

Well No. # 1 Dumler Farm

Peel-Hardman Oil Prod. Company

Peel Bros. Contractor

Wildcat

Ft. from N. Line

330


Ft. from S. Line

Ft. from E. Line

330

Ft. from W. Line

SW SW SW
Stanolind acreage

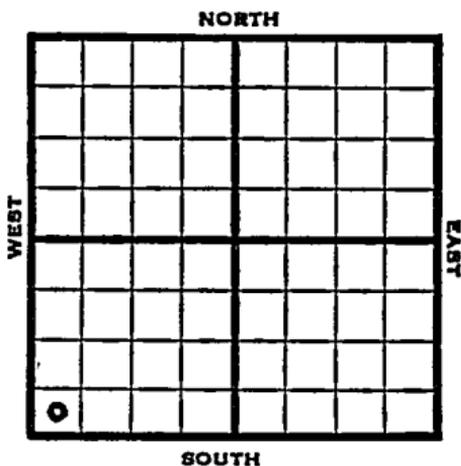

1953 Elev. 1991' REPORT

2/18 Spud 2-11-53
8" @ 878 Anhy 1152'
Drlg. 2205'

2/26 Heeb 3230, Lans 3279, Cong
3543, Arb 3554,
DST 3556-63, 1/4 hrs., 600'
gas, 240' hly OCM, 120' oil,
1000#
RTD 3563
5" @ 3556

3/12 CO 3553' S/8 BOPH

3/19 NR

3/25 Spud 2-11-53
Oil Well
TD 3563
8" @ 878
Anhy 1152, Heeb 3230, Lans
3279, Cong 3543, Arb. 3554
DST 3556-63, opn 1/4 hrs., rec.
600' gas, 240' hoem, 120' oil
1000#
TD 3563
5" @ 3556
CO to 3563
S/8 boph
Comp. 331 bopd

COMPLETED

