

Section 29 Township 34 Range 3-EWell No. #5 ShurtzCompany Sinclair-Prairie

NORTH

					Q		

WEST

EAST

SOUTH

KANSAS

Cowley

Sec. 29 Twp. 34 R. 3EWell No. #5 Shurtz Farm
Sinclair Prairie Company

Miscellaneous


990' Ft. from N. Line

Ft. from S. Line

Ft. from E. Line

990' Ft. from W. Line

SE NW NE

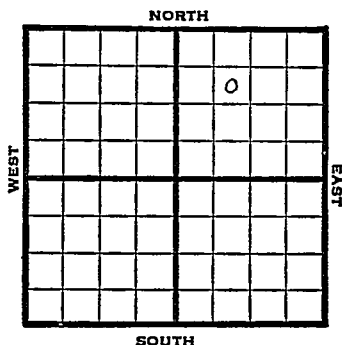

1948

Elev. 1123' REPORT

6/30

RUR

7/8

Drlg 1430'

7/14

10" @ 135'

Drlg 2628'

7/21

Bart 3325'

TD 3330'

& 7" @ 3325'

7/28

TD 3383'

8/4

"

8/11

Bart 3345'

7" @ 3325'

TD 3383'

80 qts

Pump 40 oil Pot.

Gr. 39°

COMPLETED

Map No. _____ Sec. 29 Twp. 34 R. 3E

Well No. 5 Shurtz

Sinclair-Prairie Company

FIRST REPORT Contractor

SE NW NE

SECTION PLAT

990 Ft. from N. Line

_____ Ft. from S. Line

_____ Ft. from E. Line

990 Ft. from W. Line

Cowley County

Location _____

Rig up _____

Drilling and Remarks:

R U R

RECORD

Cased _____ in., _____ ft.

Sand _____

Gas _____

Oil _____

Total Depth _____

PRODUCTION

1st 24 hrs. Nat. _____

1st 24 hrs. after shot _____

Gas _____ Cu. Ft.

Dry Hole _____

Abandoned _____

Date

JUN 30 1948 19 S. J. LEWIS Scout

Cowley County Kansas State

Map No. 1 Sec. 29 Twp. 34 R. 3E

Well No. 5 Schurtz

Sinclair-Prairie Company

COMPETITOR

Contractor

SE NW NE

E 11123
SECTION PLAT

990 Ft. from N. Line

 Ft. from S. Line

 Ft. from E. Line

990 Ft. from W. Line

Miscellaneous

Remarks:

Bar 3345

2" @ 3325

77 D 3353

809 1/2

Pen 40 sec 29

399 1/2

Date
AUG 11 1948

Scout S. J. LEWIS