

Cowley


KANSAS

Section 29 Township 34 Range 3 E

Well No. # 4 Wilson (A)

Company McNish & Grallapp

NORTH

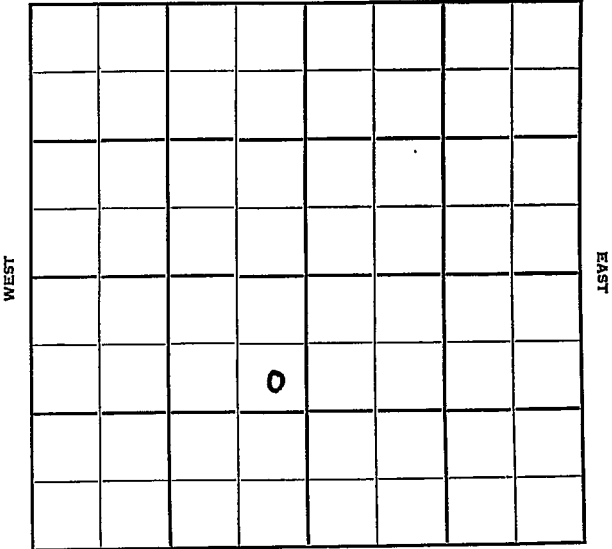

SOUTH



Sec. 29 Twp. 34 R. 3 E

Well No. # 4 Wilson (A) Farm

McNish & Grallapp Company

Watson Contractor


990 Ft. from N. Line

Ft. from S. Line

330 Ft. from E. Line

Ft. from W. Line

SE NE SW

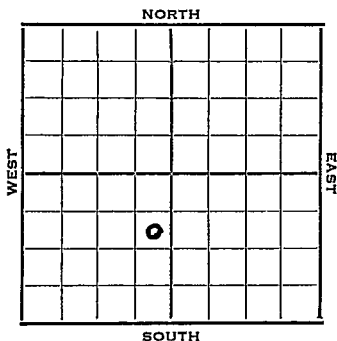

1952 Elev. 1149' REPORT

9/17 MI

1953

1/7

Spud 9-18-52

Oil Well

TD 3400

8" @ 112

Stal 2230, Bart 3370,

TD 3400 5" @ 3387 CO to 3400

Hydro.

Comp. 88 bopd

COMPLETED

