


Section 29 Township 34 Range 3 E
Well No. 5 Wilson "A"
Company McNeish & Gralapp

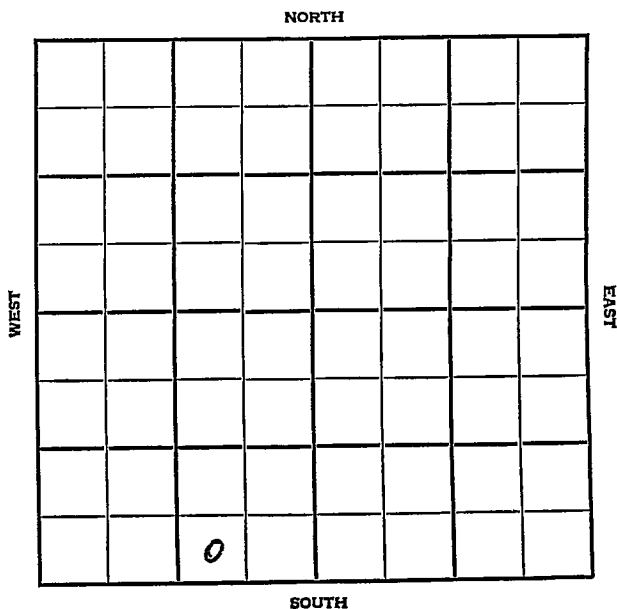

Cowley KANSAS

SEC.	TWP.	R.
29	34	3E

WELL NO.

5 Wilson "A"

FARM

COMPANY

McNeish & Gralapp

CONTRACTOR

Watson


Gibson Pool

_____ Ft. from N. Line

330 _____ Ft. from S. Line

990 _____ Ft. from E. Line

_____ Ft. from W. Line

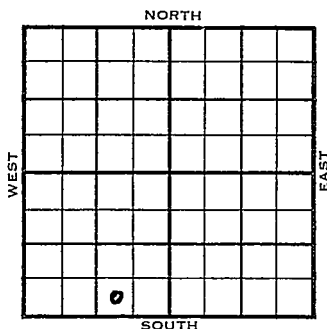

SW SE SW

1954	ELEVATION	REPORT
	1145'	


9/8 Spud 9-5-54
8" @ 95'
Drlg. 1500'

11/10 Spud 9-5-54
Oil Well
TD. 3820'
8" @ 95'
Bart. 3378', Miss 3402' Arb 3814'
TD 3816'
Simp 3774'
5" @ 3814'
DD 3820' HFW
PB 3790'
60/ 3759-81 HFW PB 3425 47/ 3381-99
sd-frac.
Comp 35 bopd.

COMPLETED

FABEN GILSTRAP

County **Cowley** State **Kansas**
 Sec. **29** (Blk. **34** (Sur. **3E** Map No.
 (Twp.) (Rge.)
 Operator **McNeish & Gralapp**
 Well No. **5** Farm **Wilson "A"**
 Elev. **1145** Location **SW SE SW**

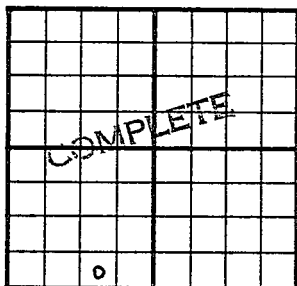

330 Ft. From **S** Line **SW**
990 Ft. From **E** Line **Quarter**
 Ist. Report
 Completion **NOV 10 1954**
 Remarks **Gibson Pool**
Watson - Contr.
 Spudding Date **9-5-54**

Drilg. Data **Oil well** **TD 3820**
8" @ 95 **Bart. 3378** **Miss. 3402**
Arb. 3814 **TD 3816** **Sipp. 3774**
5" @ 3814 **DD 3820** **HFW** **PB 3790**
60/ 3759-81 **HFW** **PB 3425** **47/ 3381-99**
sd-frac **Comp. 35 bopd**

FABEN GILSTRAP