

Sec. 19 Twp. 28 R. 4E ✓

Well No. #4 Dinyard Farm

Thrifty Drlg. Company


Miscellaneous (Thrifty, Cont.)

 Ft. from N. Line

990' Ft. from S. Line

990' Ft. from E. Line

 Ft. from W. Line

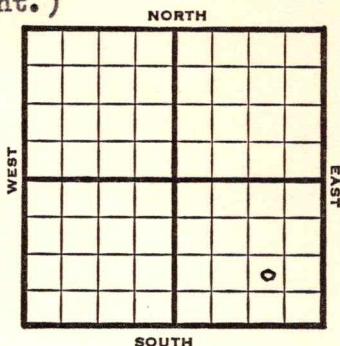

NW SE SE

1949 lev 1279' REPORT

- 7/13 Location
- 7/20 8" @ 85'
- Drlg 1560'
- 7/27 **Arb. 2470-77'**
- TD 2477
- 5" @ 2475'
- 8/3 TD 2477'
- 250 acid HFO
- "
- 8/10 TD 2477'
- 8/17 **Arb. 2470'**
- 5" @ 2475'
- 250 acid
- Pump 35 Oil Pot
- 38° Gr.
- Comp

COMPLETED

Map No. _____ Sec. 19 Twp. 28 R. 4E

Well No. 4 Dinyard

Thrifty Drlg. _____ Company

Thrifty _____ Contractor

FIRST REPORT
SECTION PLAT

SE SE

| | | | |
|--|--|--|---|
| | | | |
| | | | |
| | | | |
| | | | o |

_____ Ft. from N. Line

990 Ft. from S. Line

990 Ft. from E. Line

_____ Ft. from W. Line

Butler County

Location X

Rig up _____

Drilling and Remarks:

RECORD

Cased _____ in., _____ ft.

Sand _____

Gas _____

Oil _____

Total Depth _____

PRODUCTION

1st 24 hrs. Nat. _____

1st 24 hrs. after shot _____

Gas _____ Cu. Ft.

Dry Hole _____

Abandoned _____

Date

JUL 13 1949 19

S. J. LEWIS

Scout

Map No. K11 Sec. 19 Twp. 28 R. 4E

Well No. 4 Vinyard

Thrifty Drlg. Company

COMPLETE Contractor

NW SE SE

E 11279
SECTION PLAT

| | | | |
|--|--|--|---|
| | | | |
| | | | |
| | | | |
| | | | o |

_____ Ft. from N. Line

990 Ft. from S. Line

990 Ft. from E. Line

_____ Ft. from W. Line

Butler County

Location _____

Rig up _____

Drilling and Remarks:

Per 2470
5" @ 2475
2500 cu ft
Pump & oil 24
38° SW

RECORD

Cased _____ in., _____ ft.

Sand _____

Gas _____

Oil _____

Total Depth 2477

PRODUCTION

1st 24 hrs. Nat. _____

1st 24 hrs. after shot _____

Gas _____ Cu. Ft.

Dry Hole _____

Abandoned _____

Date

AUG 17 1949 19

S. J. LEWIS Scout