

KANSAS

Butler

✓
4E

Sec. 19 Twp. 28 R. 4E

Well No. #3 Enyard Farm _____

Thrifty Drlg. Company _____

Miscellaneous


990' Ft. from N. Line

_____ Ft. from S. Line

990' Ft. from E. Line

_____ Ft. from W. Line

SW NE SE

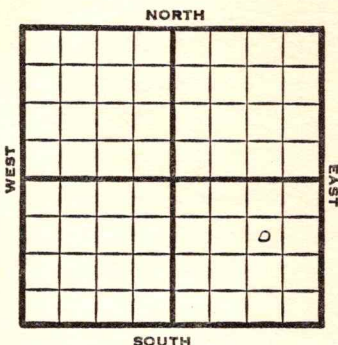

1949

Elev 1287'

R E P O R T

3/23 RUR

3/30 8" @ 100'
Drlg. 2240'

4/6 **Arbuckle 2433'**
TD 2485'
4" @ 2434'
1000' oil

4/12 5 qts CO

4/20 TD 2490'
Arb. 2434'
4" @ ~~2434~~
Pump 30 Oil Pot
38° Gr.
Comp

COMPLETED

Map No. _____ Sec. 19 Twp. 28 R. 4E

Well No. 3 Enyard

Thrifty Drlg. Company

FIRST REPORT Contractor

SW NE SE

SECTION PLAT

990 Ft. from N. Line

_____ Ft. from S. Line

990 Ft. from E. Line

_____ Ft. from W. Line

Butler County

Location _____

Rig up _____

Drilling and Remarks:

R U R

RECORD

Cased _____ in., _____ ft.

Sand _____

Gas _____

Oil _____

Total Depth _____

PRODUCTION

1st 24 hrs. Nat. _____

1st 24 hrs. after shot _____

Gas _____ Cu. Ft.

Dry Hole _____

Abandoned _____

Date

MAR 23 1949

19

S. J. LEWIS

Scout

Kansas

Map No. K11 Sec. 19 Twp. 28 R. 4E

Well No. 3 Enyard

Thrifty Drlg.


Company

COMPLETE

Contractor

SW NE SE

E. 1. 1257
SECTION PLAT

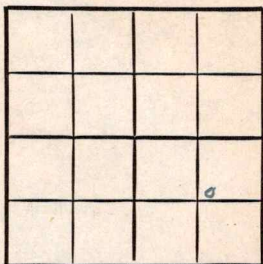

990 Ft. from N. Line

_____ Ft. from S. Line

990 Ft. from E. Line

_____ Ft. from W. Line

Butler County

RECORD

Location _____

Cased _____ in., _____ ft.

Rig up _____

Sand _____

Drilling and Remarks:

Gas _____

Oil _____

Total Depth 2490

PRODUCTION

1st 24 hrs. Nat. _____

1st 24 hrs. after shot _____

Gas _____ Cu. Ft.

Dry Hole _____

Abandoned _____

Date

APR 20 1949

19

S. J. LEWIS

Scout

CE 42434
4" CE 434
Pump 30 in. 1st
380 ft