

Butler

KANSAS

Map No. Sec. 19 Twp. 28^S R. 4^E

Well No. 1- Salter Farm

Wichita Tulsa

Company

NORTH

WEST

EAST

			0				

SOUTH

Location

Drilling Remarks

Rig Up

Drilling Remarks

RECORD

Cased in ft.

Sand

Gas

Oil

Total Depth

PRODUCTION

1st 24 hrs. Nat.

1st 24 hrs. after shot

Gas cu. ft.

Dry Hole

Abandoned

Map No. Sec. Twp. R.

Well No. Farm


..... Company

..... Ft. from N. Line

..... Ft. from S. Line

..... Ft. from E. Line

..... Ft. from W. Line

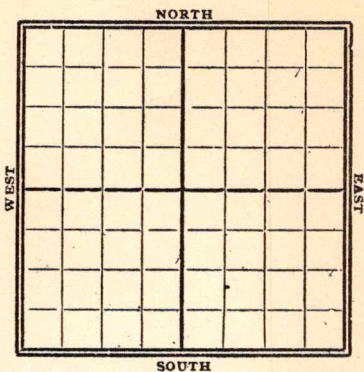

1917

Date

REPORT

Gypsy Records

9/1

Add T.D. 2930'

MAP No. KANSAS SEC. 19 TWP. 78S R. 4E

WELL No. 1 Salt

Wichita Tulsa COMPANY

CONTRACTOR

SECTION PLAT

ABANDONED

_____ FT. FROM N. LINE

_____ FT. FROM S. LINE

_____ FT. FROM E. LINE

_____ FT. FROM W. LINE

LOCATION _____

RIG UP _____

DRILLING AND REMARKS:

RECORD

CASED _____ IN. _____ FT.

SAND _____

GAS _____

OIL _____

TOTAL DEPTH 2930

PRODUCTION

1ST 24 HRS. NAT. _____

1ST 24 HRS. AFTER SHOT _____

GAS _____ Cu. Ft.

DRY HOLE _____

ABANDONED ☒

DATE

9/1 1917 _____ SCOUT