

Butler

Section 19 Township 28 Range 4E

Well No. #5 Vinyard

Company Crest Petroleum

NORTH

						0	

WEST

EAST

SOUTH

Butler

KANSAS

Sec. 19 Twp. 28 R. 4E ✓

Well No. #5 Vinyard Farm

Crest Petroleum Company

Crest Pet. Contractor


\_\_\_\_\_ Ft. from N. Line

330 Ft. from S. Line

990 Ft. from E. Line

\_\_\_\_\_ Ft. from W. Line

SW SE SE

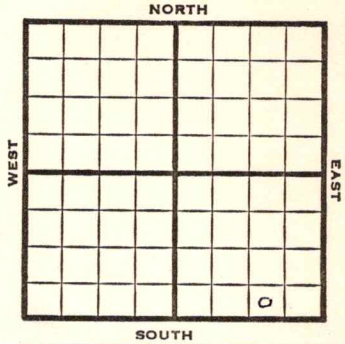

1951

**Elev. 1273'** REPORT

10/31

Spud 10-27-51  
8" @ 84  
Drlg. 1220'

11/28

Spud 10-27- 51  
Oil Well TD 2482  
8" @ 84  
**Arb. 2470-74** 5" @ 2471'  
TD 2482 500 A  
S/4 goph 4 hr. 500A  
Comp. 25 bopd

**COMPLETED**



