


Section 30 Township 34S Range 3E
Well No. #2 Weir
Company L. C. Smitherman

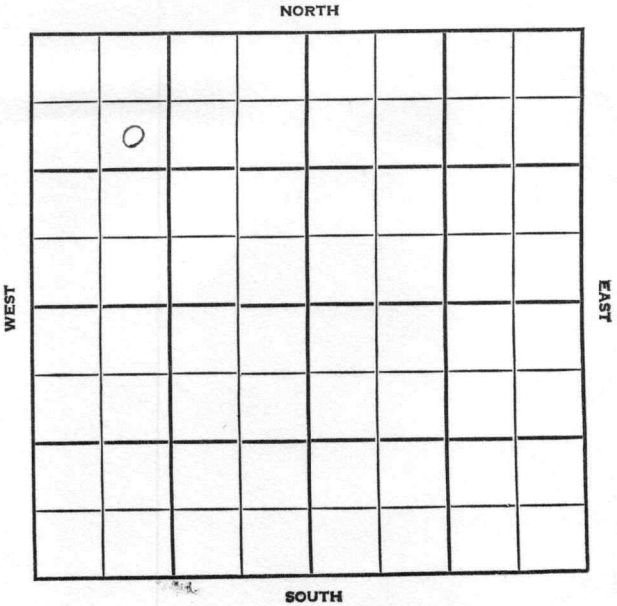

Cowley

KANSAS

SEC. 30	TWP. 34S-	R. 3E
------------	--------------	----------

WELL NO. 2 Weir FARM

COMPANY


L. C. Smitherman
CONTRACTOR

_____ FT. FROM N. LINE

_____ FT. FROM S. LINE

_____ FT. FROM E. LINE

_____ FT. FROM W. LINE

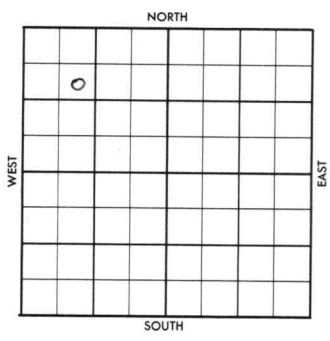

SE NW NW

	ELEVATION	REPORT
1956	1166'	

6-20 Location

7-18 Comm. 6-22-56
 8 5/8" @ 117
 5 1/2" @ 3449
 36/3432-39
 Flw 230 B0 / 20 BW, 12 hrs.
 Flw 25 B0, / 2 BW PD
 Bartl. 3430'; Base 3440
 TD 3449'

COMPLETED

County Cowley Elev. _____
 Sec. 30 Twp. 34S Rge. 3E
 Company L. C. Smitherman
 Farm Name Weir No. 2

Co.

TOPS	DEPTH	LOG	DATUM
Anh.			
TP.			
H.			
Tr.			
Dg.			
Bl.			
L.			
K.C.			
B.K.C.			
Ce.			
C.			
M.			
M.			
K.			
Mz.			
Me.			
V.			
S.			
S.			
A.			
R.			
PE.			
G.			
T.D.			

Loc. in Sec. SE NW NW

Geol. _____

Contr. _____

Pool _____



Lse.

No.

Sec.

T.

R.

Date Comm. Loc. JUN 20 '56

2/9

ANN. S. 1956

Co.

County Cowley Elev. 1166
 Sec. 30 Twp. 34S Rge. 3E
 Company L. C. Smitheman
 Farm Name Weir No. 2

TOPS	DEPTH	LOG	DATUM	Loc. in Sec.
Anh.				SE NW NW
TP.				
H.				
Tr.	<u>Bartl. 3430</u>			
Dg.	<u>Base 3440</u>			
Bl.				
L.				Geol.
K.C.				Contr.
B.X.C.				
Ce.				
C.				
M.				Pool
M.				<u>SIRC. F.O.</u>
K.				
Mz.				
Ma.				
V.				
S.				
S.				COMPLETE
A.				
R.				
PE.				JUL 18 1956
G.				
T.D.	<u>3449</u>			

Lse.

19 No.

Sec.

T.

R.

Date Comm. Loc. JUN 27 '56 6-22-56
8 5/8 117 @ 2130 JUL 3 '56
5/2 @ 3449 JUL 11 '56 36/3432-39
JUL 18 '56 FRAC F/W 230 B0 +
20 BW 12 hrs @ F/W 25 B0
+ 2 BWpd.