


Map No. _____ Sec. 20 Twp. 28 R. 4
 Well No. 8 Blood Farm _____
Mid Kansas Company _____

NORTH

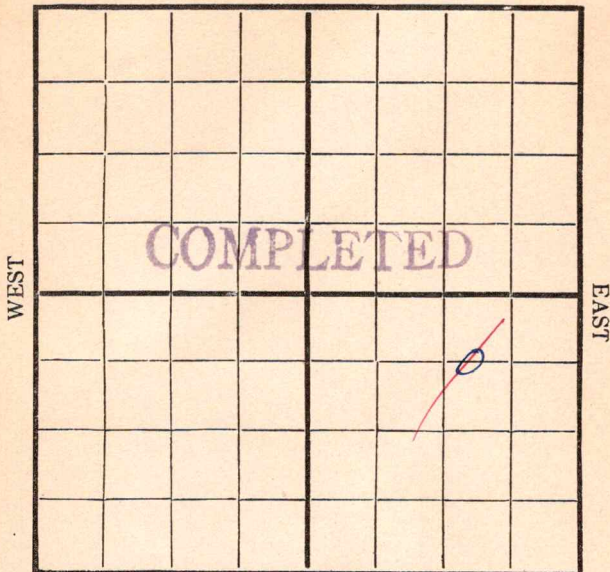

SOUTH

Location _____

Drilling Remarks:

7/ 271 260

Rig Up _____

Drilling Remarks:

RECORD

Cased _____ in _____ Ft.
 Sand _____
 Gas _____
 Oil _____
 Total Depth _____


PRODUCTION

1st 24 hrs. Nat. _____
 1st 24 hrs. after shot _____
 Gas _____ Cu. Ft.
 Dry Hole _____
 Abandoned _____

Map No. _____ Sec. 20 Twp. 28 R. 4
 Well No. 813 land Farm _____
and K... Company _____

NORTH

WEST

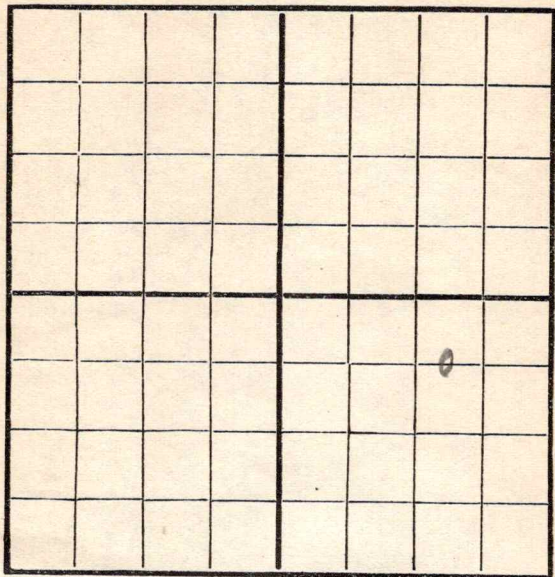

EAST

SOUTH

Location _____
 Rig Up _____
 Drilling and remarks _____

1260'

RECORD

Cased _____ in. _____ Ft.
 Sand _____
 Gas _____
 Oil _____
 Total Depth _____

PRODUCTION


1st 24 hrs. Nat. _____
 1st 24 hrs. after shot _____
 Gas _____ Cu. Ft.
 Dry Hole _____
 Abandoned _____

Date

7/12, 1916 Alley Scout

Map No. _____ Sec. 20 Twp. 28 R. 4Well No. 813 Farm _____Wing Kansas Company

NORTH

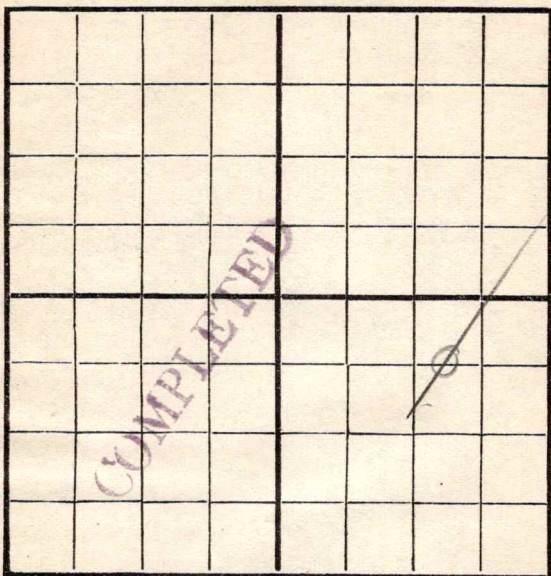

SOUTH

Location _____

Rig Up _____

Drilling and remarks

Looks like abandoned
well. Rig has
been dismantled

Salt water
pouring out
of 6 5/8" casing

RECORD

Cased _____ in. _____ Ft.

Sand _____

Gas _____

Oil _____

Total Depth _____

PRODUCTION

1st 24 hrs. Nat. _____

1st 24 hrs. after shot _____

Gas _____ Cu. Ft.

Dry Hole _____

Abandoned _____

Date

7/21


191

W. B. Bland

Scout

Is this location correct?
 map shows No. 14 gas
 well at this location &
 No. 8 one location
 south.

Miller

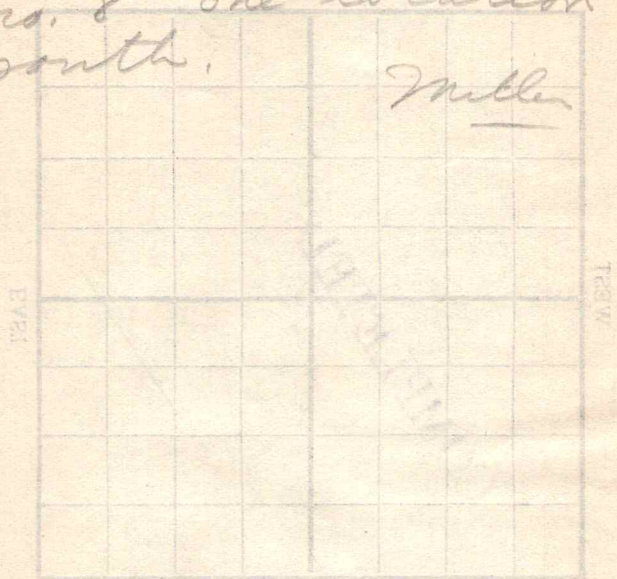

SOUTH

RECORD		Location	
ft	in	Cased	For top
		Sand	
		Gas	
		Oil	
		Total Depth	
PRODUCTION		Drilling and remarks	
1st 24 hrs	Net		
1st 24 hrs	after shut		
Gas			
Oil			
Abandoned			
6161 42 111		Date	
1916			