


Section 32 Township 34 Range 3 E

Well No. # 9 Baird-Drennan

Company Aladdin Pet.

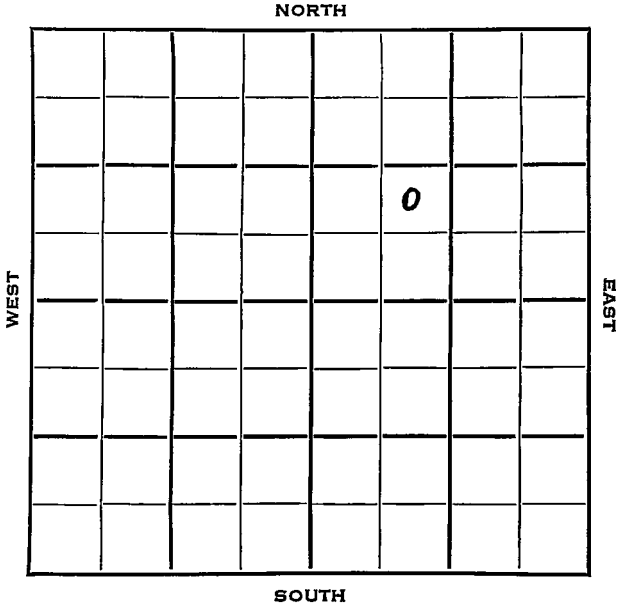

Cowley

KANSAS
3E


SEC. 32	TWP. 34	R.
------------	------------	----

WELL NO #9 Baird-Drennan FARM

COMPANY Aladdin Pet.

CONTRACTOR Crowe Drlg.

_____ Ft. from N. Line
990 _____ Ft. from S. Line
_____ Ft. from E. Line
990 _____ Ft. from W. Line

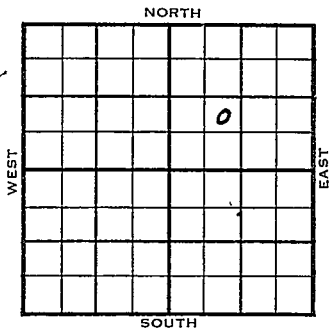

NE SW NE.

1953 ELEVATION 1140' REPORT

9/9 R U R
11/11 Spud 9-19-53
Oil Well
TD 3395'
8" @ 135'
Layton 2656', KC 2840', Marm. 3055',
Bart 3365'
TD 3395'
5" @ 3365'
GO to 3395',
PB 3382'
Hydro.
F/55 boph
Comp. 1798 bopd

COMPLETED

