


Section 31 Township 34 Range 3E

Well No. #1 Johnson

Company Hill & Hill

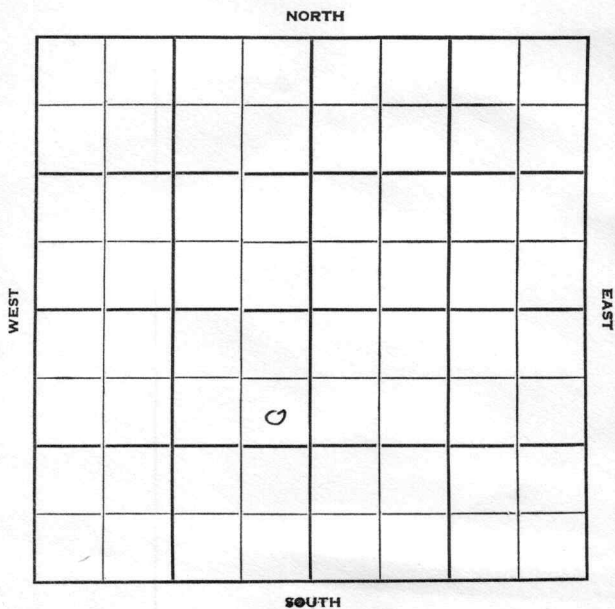

Cowley **KANSAS**

Sec. 31 Twp. 34 R. 3E

Well No. #1 Johnson Farm

Hill & Hill Company

Watson - Contr. Contractor


990' Ft. from N. Line

 Ft. from S. Line

330' Ft. from E. Line

 Ft. from W. Line

SE NE SW

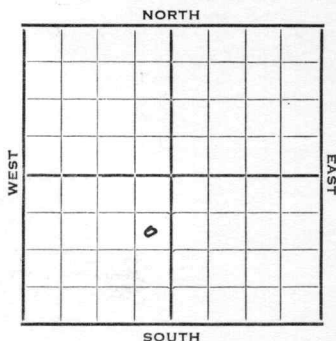


1952 Elev. 1191' REPORT

3/19 Location

4/16 Spud 3-26-52
D&A TD 3565
8" @ 115' Stal 2311
Layton 2769 KC 2952
Bart 3465 Miss Chat 3505
Miss Lime 3525 TD 3565
D&A

ABANDONED

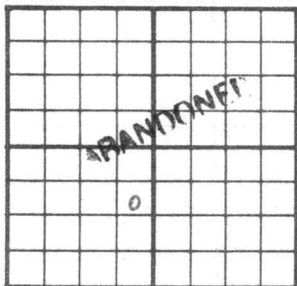County Cowley State KansasSec. 31 (Blk.) 34 (Sur.) 3E (Twp.) Map No.Operator Hill & HillWell No. 1 Farm JohnsonElev. 1191 Location SE NE SW990 Ft. From N Line SW330 Ft. From E Line Quarter

1st. Report

Completion APR 16 1952

Remarks

Watson - Contr.Spudding Date 3-26-52Drlg. Data D & A TD 35658" @ 115 Stal. 2311 Layton 2769KC 2952 Bart. 3465 Miss. chat 3505Miss. lime 3525 TD 3565D & A

J. G. McGEHEE