


Section 20
21 Township 28 Range 1E

Well No. 3 Blood

Company Morris Sitrin

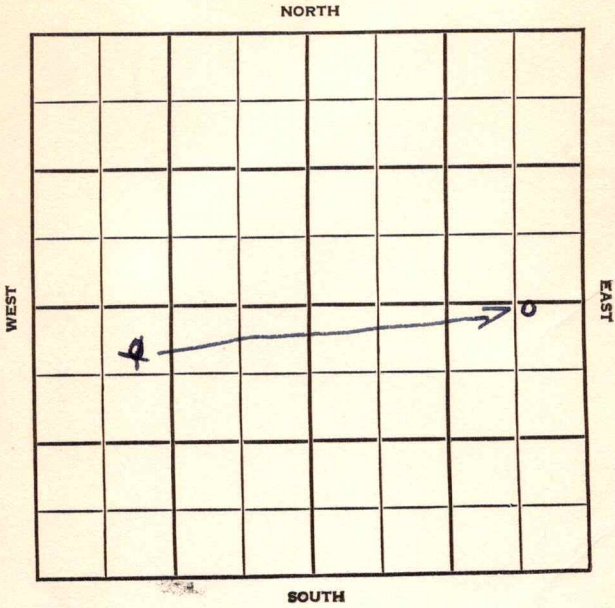

SEC. <u>20</u> <u>21</u>	TWP. 28	R. 4E
-----------------------------	---------	-------

WELL NO.

3 Blood

FARM

COMPANY

Morris Sitrin

CONTRACTOR

H & M Drlg.

Augusta Pool


150
330 Ft. from N. Line

_____ Ft. from S. Line

500 Ft. from E. Line

990 Ft. from W. Line

NE NE SE
NE NW SW

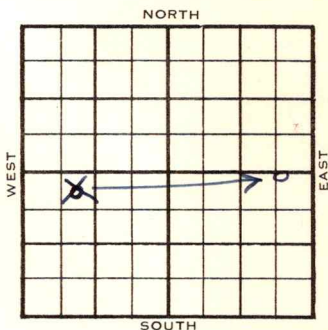

1954

ELEVATION

1201'

REPORT

8/25

MIR

9/22

Oil Well

TD 2530'

8" @ 50'

KC 1988'

TD 2530'

5" @ 2529'

Arb 2455'

9/ 2482-85 P/ 70 bo

Comp 25 bopd.

COMPLETED

County Butler State KansasSec. 20 (Blk.
Twp.) 28 (Sur.
Rge.) 4E Map No.Operator Morris SitrinWell No. 3 Farm BloodElev. 1201 Location NE NE SE150 Ft. From N Line SE500 Ft. From E Line Quarter1st. Report Aug 25 1954Completion SEP 22 1954

Remarks

H.&M. Drlg. - Contr.

Spudding Date

Drlg. Data Oil well TD 2530 Augusta Pool8" @ 50 KC 1988 TD 2530 5" @ 2529Arb. 2455 9/ 2482-85 P/ 70 boComp. 25 bopd

FABEN GILSTRAP

Kansas

Map No. _____ Sec. 20 Twp. 28 R. 4EWell No. 3 Blood_____
Morris Sitrin _____ Company**CORRECTION** _____ Contractor

NE NE SE


SECTION PLAT

150 Ft. from N. Line

_____ Ft. from S. Line

500 Ft. from E. Line

_____ Ft. from W. Line

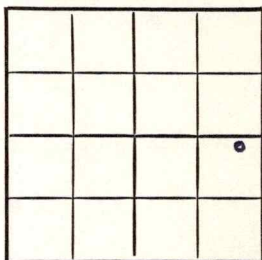

Butler County

Location _____

Rig up _____

Drilling and Remarks:

Reported

21-28-4E

NE NW SW

RECORD

Cased _____ in., _____ ft.

Sand _____

Gas _____

Oil _____

Total Depth _____

PRODUCTION

1st 24 hrs. Nat. _____

1st 24 hrs. after shot _____

Gas _____ Cu. Ft.

Dry Hole _____

Abandoned _____

Date

FABEN GILSTRAP

SFP

1 1954 19

Scout

County **Butler** State **Kansas**

Sec. **21** (Blk. **28** (Sur. **4E** Map No.

Operator **Morris Sitrin**

Well No. **3** Farm **Blood**

[illegible][illegible]

330 Ft. From N Line SW

990 Ft. From **W** Line Quarter

1st. Report AUG 25 1954

Completion

Remarks

H & M Drlg. - Contr.

Spudding Date _____

Drig. Data

M I R

FABEN GILSTRAP