

Sec. 31 Twp. 34 R. 3E

Well No. #1 Leo Marrs Farm

Sinclair Company

Wakefield Contractor


990 Ft. from N. Line

_____ Ft. from S. Line

330 Ft. from E. Line

_____ Ft. from W. Line

SE NE SE

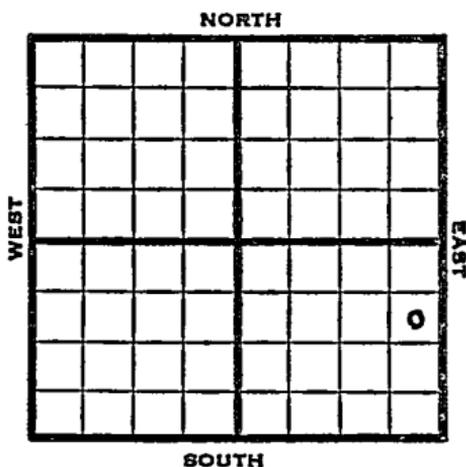

1953

Elev. 1162' REPORT

7/29

Location

11/4

Spud 8-3-53
 Oil Well
 TD 3450'
 10" @ 135'
 Severy sd. 1502'
 DST 1484-1508, opn 1/2 hrs., rec.
 30' mud, 225#
 Lans 2235', Stal 2260', Layton 2717',
 KC 2901', Bart 3412', Miss 3448'
 TD 3450',
 5" @ 3415'
 PB 3444
 SP 3400
 Sd-frac
 S/7 boph 15 1/2 bw
 S/18 bo 200 bw 14 hrs.
 P/13 bo 190 bw 19 hrs.
 P/11 bo 251 bopd
 Comp. 11 bo 200 bwpd

COMPLETED

