

Misc.

WEST

EAST

SOUTH

Butler **KANSAS**

4E ✓

Sec. 20 Twp. 28 R. 4E

Well No. #4 Blood Farm

Aikman & Braden Company

Miscellaneous (Braden, Cont.) **NORTH**


660' Ft. from N. Line

Ft. from S. Line

660' Ft. from E. Line

Ft. from W. Line

C NE SE

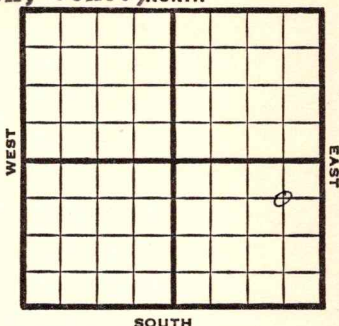

1949

Elev 1202'

R E P O R T

8/17 Machine

8/24 "

8/31 Spud

9/7 Drlg. 465'

9/14 Drlg 701'

9/21 13"@ 701'

Drlg. 1285'

9/28 10"@ 1469'

Lansing 1985'

Drlg 2080'

10/5 Arb. **2445'-47'**

TD 2447'

Run 6"

10/12 "

10/19 TD 2483'

Arb. 2445'

6"@ 2445'

Pump 15 Oil Pot


38° Gr.

Comp

COMPLETED

Map No. _____ Sec. 20 Twp. 28 R. 4EWell No. 4 Blood_____
Aikman & Braden Company_____
Braden Contractor

C NE SE

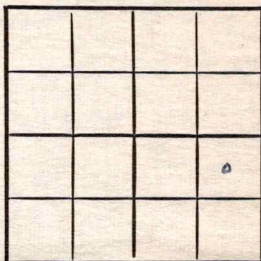FIRST REPORT
SECTION PLAT660 Ft. from N. Line_____
Ft. from S. Line660 Ft. from E. Line_____
Ft. from W. LineButler County

Location _____

Rig up _____

Drilling and Remarks:

Machine _____

RECORD

Cased _____ in., _____ ft.

Sand _____

Gas _____

Oil _____

Total Depth _____

PRODUCTION

1st 24 hrs. Nat. _____

1st 24 hrs. after shot _____

Gas _____ Cu. Ft.

Dry Hole _____

Abandoned _____

Date

AUG 17 194919S. J. LEWISScout

Map No. _____ Sec. 20 Twp. 28 R. 4EWell No. 4 Blood_____ Aikman & Braden _____ Company**COMPLETE**_____
Contractor

C NE SE

E11202
SECTION PLAT660 _____ Ft. from N. Line

_____ Ft. from S. Line

660 _____ Ft. from E. Line

_____ Ft. from W. Line

			o

Butler County

Location _____

Rig up _____

Drilling and Remarks:

Cut 2445.6" C 2445Prod 15 oil 1st350 cu**RECORD**

Cased _____ in., _____ ft.

Sand _____

Gas _____

Oil _____

Total Depth 2483**PRODUCTION**

1st 24 hrs. Nat. _____

1st 24 hrs. after shot _____

Gas _____ Cu. Ft.

Dry Hole _____

Abandoned _____

Date

OCT 19 1949

19

S. J. LEWIS Scout